

FLORIDA DEPARTMENT OF
Business & Professional Regulation



[DBPR HOME](#) | [ABOUT DBPR](#) | [DBPR DIVISIONS](#) | [CONTACT DBPR](#)

[BCIS Home](#) | [Log In](#) | [User Registration](#) | [Hot Topics](#) | [Submit Surcharge](#) | [Stats & Facts](#) | [Publications](#) | [Contact Us](#) | [BCIS Site Map](#) | [Links](#) | [Search](#)



Product Approval
USER: Public User

[Product Approval Menu](#) > **Application Detail**

FL #

FL46976-R1

Application Type

Revision

Code Version

2023

Application Status

Approved

Comments

Archived



Product Manufacturer

Custom Window Systems Inc.

Address/Phone/Email

1900 SW 44th Avenue
Ocala, FL 34474
(352) 368-6922
certifications@cws.cc

Authorized Signature

Jalal Farooq
veronica@afceng.com

Technical Representative

Mary Rukashaza-Mukome

Address/Phone/Email

1900 SW 44th Avenue
Ocala, FL 34474
(641) 621-3317
rukashazamc@pella.com

Quality Assurance Representative

Steven Bailey

Address/Phone/Email

8501 NW 90th St.
Medley, FL 33166
(305) 696-8660
sbailey@cws.cc

Category

Exterior Doors

Subcategory

Swinging Exterior Door Assemblies

Compliance Method

Evaluation Report from a Florida Registered Architect or a Licensed Florida Professional Engineer

☐ Evaluation Report - Hardcopy Received

Florida Engineer or Architect Name who developed the Evaluation Report

Jalal Farooq

Florida License

PE-81223

Quality Assurance Entity

National Accreditation and Management Institute

Quality Assurance Contract Expiration Date

12/31/2025

Validated By

Abel Carrasco, PE

☒ Validation Checklist - Hardcopy Received

Certificate of Independence

[FL46976_R1_COI_SS - Certificate of Independence 2023.pdf](#)

Referenced Standard and Year (of Standard)

Standard

Year

TAS 201

1994

TAS 202

1994

Equivalence of Product Standards
Certified By

Sections from the Code

Product Approval Method

Method 1 Option D

Date Submitted

10/22/2024

Date Validated

10/24/2024

Date Pending FBC Approval

10/26/2024

Date Approved

12/10/2024

Summary of Products

FL #	Model, Number or Name	Description
46976.1	Series 360 Aluminum Outswing Entrance Door	Non-impact resistant aluminum outswing entrance door.
Limits of Use Approved for use in HVHZ: Yes Approved for use outside HVHZ: Yes Impact Resistant: No Design Pressure: +100/-100 Other: See attached drawing 21-32F for installation instructions and applicable design pressures for various configurations.		Installation Instructions FL46976_R1_II_SS - 360 FD (NI) - DWG 21-32F 2023 R1.pdf Verified By: Jalal Farooq PE # 81223 Created by Independent Third Party: Yes Evaluation Reports FL46976_R1_AE_SS - 360 FD (NI)-PAE 2023.pdf Created by Independent Third Party: Yes
46976.2	Series 7600 Aluminum Outswing Entrance Door	Large missile impact resistant aluminum outswing entrance door.
Limits of Use Approved for use in HVHZ: Yes Approved for use outside HVHZ: Yes Impact Resistant: Yes Design Pressure: +75/-80 Other: See attached drawing 21-14F for installation instructions and applicable design pressures for various configurations.		Installation Instructions FL46976_R1_II_SS - 7600 FD (LMI) - DWG 21-14F 2023 R1.pdf Verified By: Jalal Farooq PE # 81223 Created by Independent Third Party: Yes Evaluation Reports FL46976_R1_AE_SS - 7600 FD (LMI)-PAE 2023.pdf Created by Independent Third Party: Yes

[Back](#)

[Next](#)


[Contact Us](#) :: [2601 Blair Stone Road, Tallahassee FL 32399](#) Phone: 850-487-1824

The State of Florida is an AA/EEO employer. [Copyright 2007-2013 State of Florida.](#) :: [Privacy Statement](#) :: [Accessibility Statement](#) :: [Refund Statement](#)

Under Florida law, email addresses are public records. If you do not want your e-mail address released in response to a public-records request, do not send electronic mail to this entity. Instead, contact the office by phone or by traditional mail. If you have any questions, please contact 850.487.1395. *Pursuant to Section 455.275(1), Florida Statutes, effective October 1, 2012, licensees licensed under Chapter 455, F.S. must provide the Department with an email address if they have one. The emails provided may be used for official communication with the licensee. However email addresses are public record. If you do not wish to supply a personal address, please provide the Department with an email address which can be made available to the public. To determine if you are a licensee under Chapter 455, F.S., please click [here](#).

Product Approval Accepts:



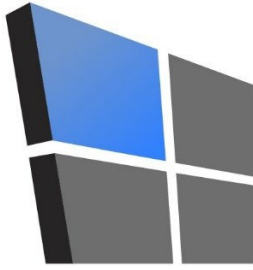

AL-FAROOQ CORPORATION

CONSULTING ENGINEERS & PRODUCT DEVELOPMENT

January 23, 2023

Product Approval Administrator
Building Codes & Standards Section
Department of Business & Professional Regulations
1940 North Monroe Street, Suite 90
Tallahassee, FL 32399-2100

To whom it may concern,


As the design engineer retained to prepare the product approval(s) associated with this letter as shown below on this same web page, I do hereby declare that I do not have and will not have any financial interest in any company manufacturing or distributing the referenced product(s), nor do I have or will have any financial interest with any other entity involved in the approval process of the referenced product(s).

Sincerely,



Jalal Farooq, P.E.
CFO

Sealed: 1/23/2023

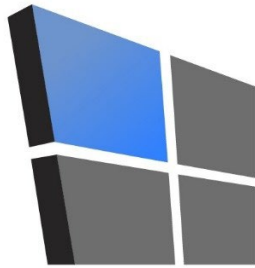

AL-FAROOQ CORPORATION

CONSULTING ENGINEERS & PRODUCT DEVELOPMENT

PRODUCT APPROVAL EVALUATION RULE CHAPTER #61G20-3 • METHOD 1 OPTION D

FL 46976

Date: 08/23/2024

Detailed Product Description:

Manufacturer: CUSTOM WINDOW SYSTEMS INC.

Manufacturer Address: 1900 SW 44th AVENUE OCALA, FL 34474

Model Name: SERIES 7600 ALUMINUM OUTSWING ENTRANCE DOOR

Maximum Load: +75 PSF, -80 PSF (Large Missile Impact)

Installation Drawings # 21-14F

This product complies with the High Velocity Hurricane Zone (HVHZ) testing requirements.

For maximum sizes, combination of span vs loads and anchor type refer to installation drawings.

Comparative analysis used ☐ Yes ☒ No

Mandatory Tests (Tested in accordance with AAMA 101/I.S.2/NAFS/TAS-202)

TEST	DESCRIPTION	TEST LOCATION	TEST REPORT DATE	TEST REPORT #	Test Sealed by
ASTM E283	Air Infiltration Leakage	National Certified Testing Laboratories	10/22/2020	NCTL-210-4179-01	Douglas J. McDougall, PE
ASTM E331 OR ASTM 547 & TAS 202	Water Penetration	National Certified Testing Laboratories	10/22/2020	NCTL-210-4179-01	Douglas J. McDougall, PE
ASTM E330 & TAS 202	Uniform Static Air Press.	National Certified Testing Laboratories	10/22/2020	NCTL-210-4179-01	Douglas J. McDougall, PE
AAMA 1304	Forced Entry Test	National Certified Testing Laboratories	10/22/2020	NCTL-210-4179-01	Douglas J. McDougall, PE

Supplemental Tests (Tested in accordance with TAS-201 and TAS-203)

TEST	DESCRIPTION	TEST LOCATION	TEST REPORT DATE	TEST REPORT #	Test Sealed by
FBC 1626.2 (TAS 201 & 203)	Large Missile Impact & Cyclic	National Certified Testing Laboratories	10/22/2020	NCTL-210-4179-01	Douglas J. McDougall, PE

Under the limitations of the attached installation drawings, to the best of my knowledge and ability, the above product conforms to the requirements of the 2023 Florida Building Code.


Evaluation Report Engineer:

Jalal Farooq
Al-Farooq Corporation

PE # 81223
EB # 3538



Sealed: 08/23/2024

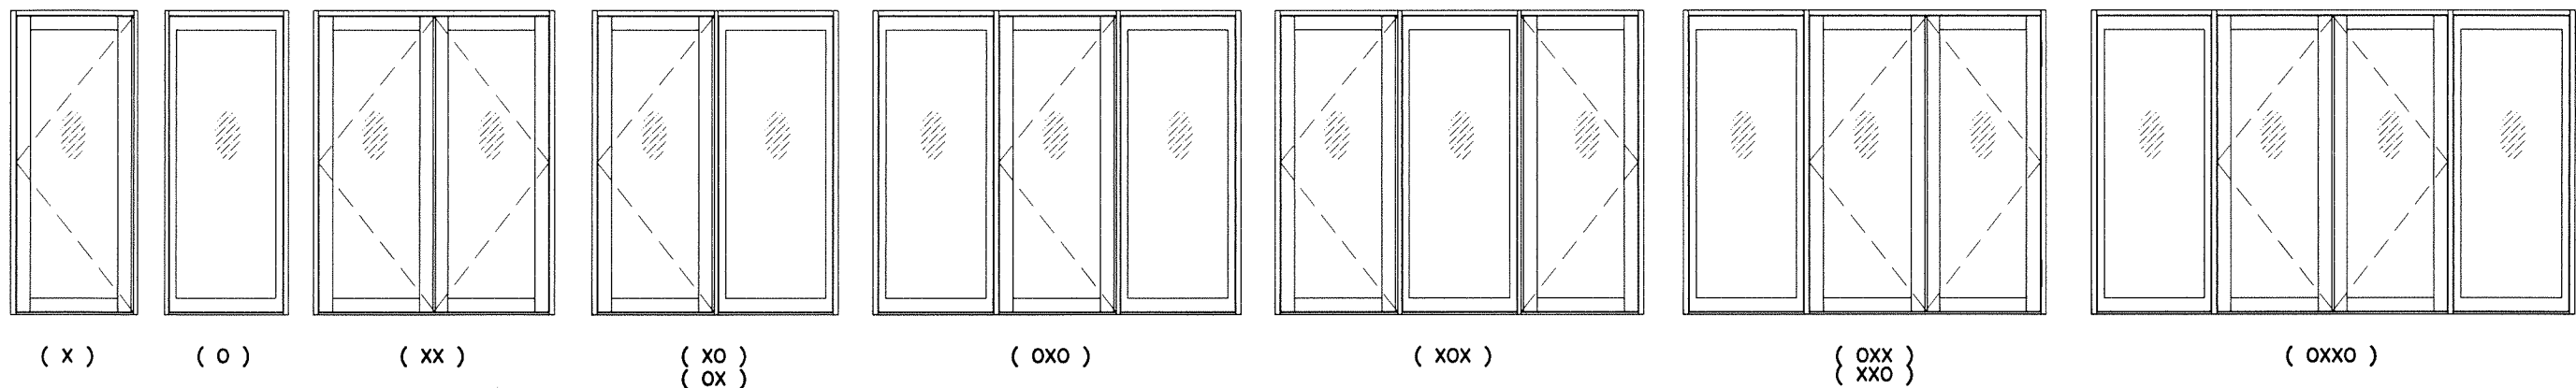

APPROVED CONFIGURATIONS

XX, OXX, XXO AND OXXO DOORS MAY HAVE UN-EQUAL PANEL WIDTHS.

OXO, AND OXXO DOORS MAY HAVE UN-EQUAL SIDELITE WIDTHS.

ALL CONFIGURATIONS MAY HAVE HI-RISE RAILS ON BOTH OR EITHER TOP AND BOTTOM OF PANELS.

THESE DOORS ARE RATED FOR LARGE & SMALL MISSILE IMPACT.
SHUTTERS ARE NOT REQUIRED.

SERIES 7600

ALUMINUM IMPACT OUTSWING ENTRANCE DOOR

APPROVAL APPLIES TO SINGLE (X) AND DOUBLE (XX) LEAF DOORS
WITH OR WITHOUT SIDELITES.

SIDE LITES CAN BE ON ONE OR BOTH SIDES OF DOOR.

DOORS WITH STD. THRESHOLDS (LAW-2402 & LAW-2403) APPROVED
FOR INSTALLATIONS WHERE WATER INFILTRATION RESISTANCE IS REQUIRED.

DOORS WITH ADA THRESHOLD (LAW-2421) NOT APPROVED FOR WATER INFILTRATION RESISTANCE.

SEE SHEET 6 FOR DETAILS.

THIS PRODUCT HAS BEEN DESIGNED AND TESTED TO COMPLY WITH THE REQUIREMENTS OF THE 2023 (8TH EDITION) FLORIDA BUILDING CODE INCLUDING HIGH VELOCITY HURRICANE ZONE (HVHZ).

1BY OR 2BY WOOD BUCKS & BUCK FASTENERS BY OTHERS, MUST BE DESIGNED AND INSTALLED ADEQUATELY TO TRANSFER APPLIED PRODUCT LOADS TO THE BUILDING STRUCTURE.

ANCHORS SHALL BE CORROSION RESISTANT, SPACED AS SHOWN ON DETAILS AND INSTALLED PER MANUF'S INSTRUCTIONS. SPECIFIED EMBEDMENT TO BASE MATERIAL SHALL BE BEYOND WALL DRESSING OR STUCCO.

A LOAD DURATION INCREASE IS USED IN DESIGN OF ANCHORS INTO WOOD ONLY.

ALL SHIMS TO BE HIGH IMPACT, NON-METALLIC AND NON-COMPRESSIBLE.

MATERIALS INCLUDING BUT NOT LIMITED TO STEEL/METAL SCREWS, THAT COME INTO CONTACT WITH OTHER DISSIMILAR MATERIALS SHALL MEET THE REQUIREMENTS OF THE 2023 FLORIDA BLDG. CODE & ADOPTED STANDARDS.

THIS PRODUCT APPROVAL IS GENERIC AND DOES NOT PROVIDE INFORMATION FOR A SITE SPECIFIC PROJECT, I.E. LIFE SAFETY OF THIS PRODUCT, ADEQUACY OF STRUCTURE RECEIVING THIS PRODUCT AND SEALING AROUND OPENING FOR WATER INFILTRATION RESISTANCE ETC.

CONDITIONS NOT SHOWN IN THIS DRAWING ARE TO BE ANALYZED SEPARATELY,
AND TO BE REVIEWED BY BUILDING OFFICIAL.

DESIGN LOADS SHOWN ARE BASED ON 'ALLOWABLE STRESS DESIGN (ASD)'.

MANUFACTURER'S LABEL SHALL BE LOCATED ON A READILY VISIBLE LOCATION
IN ACCORDANCE WITH SECTION 1709.9.3 OF FLORIDA BUILDING CODE.

LABELING TO COMPLY WITH SECTION 1709.9.2.

INSTRUCTIONS:

USE CHARTS AS FOLLOWS.

- STEP 1** DETERMINE DESIGN WIND LOAD REQUIREMENT BASED ON WIND VELOCITY, BLDG. HEIGHT, WIND ZONE USING APPLICABLE ASCE 7 STANDARD.
- STEP 2** FOR SINGLE (X) AND DOUBLE (XX) DOOR CAPACITIES SEE SHEETS 3 & 3.1.
- STEP 3** FOR SIDELITE PANEL (O) CAPACITY SEE SHEET 4.
- STEP 4** FOR SIDELITE COMBINATION WITH DOOR SEE MULLION CAPACITY CHART ON SHEET 5.
- STEP 5** FOR HARDWARE LIMITATIONS SEE SHEET 12.
- STEP 6** THE LOWEST VALUE RESULTING FROM STEPS 2, 3, 4 AND 5 SHALL APPLY TO ENTIRE SYSTEM.

Sealed: 10/22/2024

FL #46976


LARGE MISSILE IMPACT
LAMINATED GLASS
INSUL. LAM. GLASS

A- CONTRACTOR TO BE RESPONSIBLE FOR THE SELECTION, PURCHASE AND INSTALLATION OF THIS PRODUCT BASED ON THIS PRODUCT EVALUATION PROVIDED HE/SHE DOES NOT DEVIATE FROM THE CONDITIONS DETAILED ON THIS DOCUMENT.

B- THIS PRODUCT EVALUATION DOCUMENT WILL BE CONSIDERED INVALID IF
ALTERED BY ANY MEANS.

C- SITE SPECIFIC PROJECTS SHALL BE PREPARED BY A FLORIDA REGISTERED ENGINEER OR ARCHITECT WHICH WILL BECOME THE ENGINEER OF RECORD (E.O.R.) FOR THE PROJECT AND WHO WILL BE RESPONSIBLE FOR THE PROPER USE OF THE P.E.D. ENGINEER OF RECORD, ACTING AS A DELEGATED ENGINEER TO THE P.E.D. ENGINEER SHALL SUBMIT TO THIS LATTER THE SITE SPECIFIC DRAWINGS FOR REVIEW.

D- THIS P.E.D. SHALL BEAR THE DATE AND ORIGINAL SEAL AND SIGNATURE OF THE PROFESSIONAL ENGINEER OF RECORD THAT PREPARED IT.

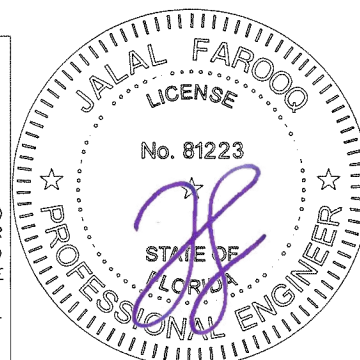

AL-FAROOQ CORPORATION
ENGINEERS & PRODUCT DEVELOPMENT
9360 SUNSET DRIVE, SUITE 220
MIAMI, FLORIDA 33173 (C.A.N. 3538)
TEL. (305) 264-8100 FAX. (305) 262-6978

SERIES 7600 ALUMINUM OUTSWING DOOR (L.M.I.)

Custom Window Systems Inc.
1900 S.W. 44th Avenue
Ocala, FL 34474
Tel. (352) 368-6922
www.cws.cc

drawing no.

21-14F

sheet 1 of 15

date: 02-22-21









scale: -

dr. by: TARIQ


chk. by:

revisions:

no	date	description
A	06.26.23	SUPER SPACER ADDED
B	09.27.23	UPDATED TO 2023 FBC
C	01.24.24	LOCK OPTION 3 REV.
D	08.08.24	MANUF. NAME REV.
E	10.18.24	RADISSON LOCKS ADDED

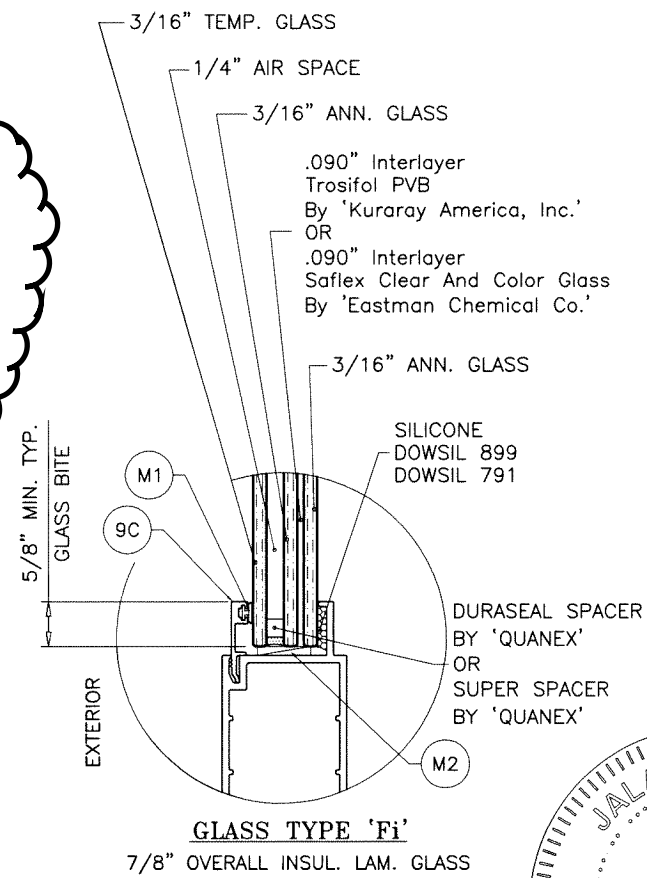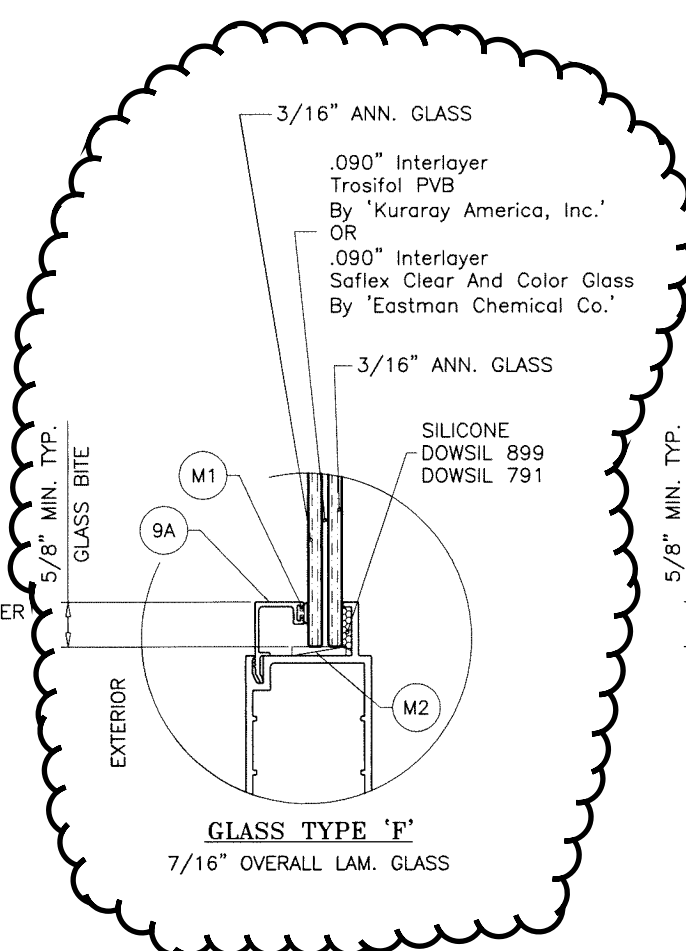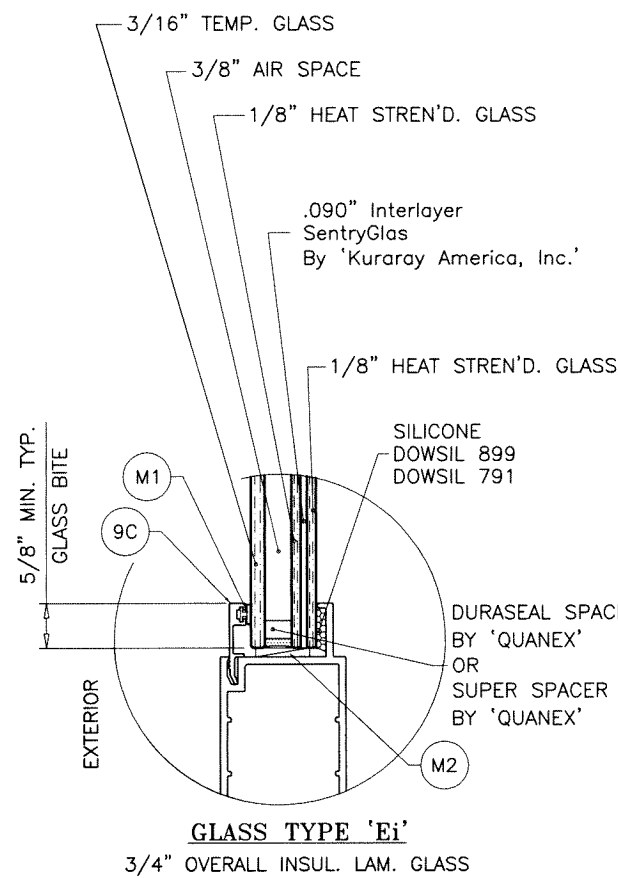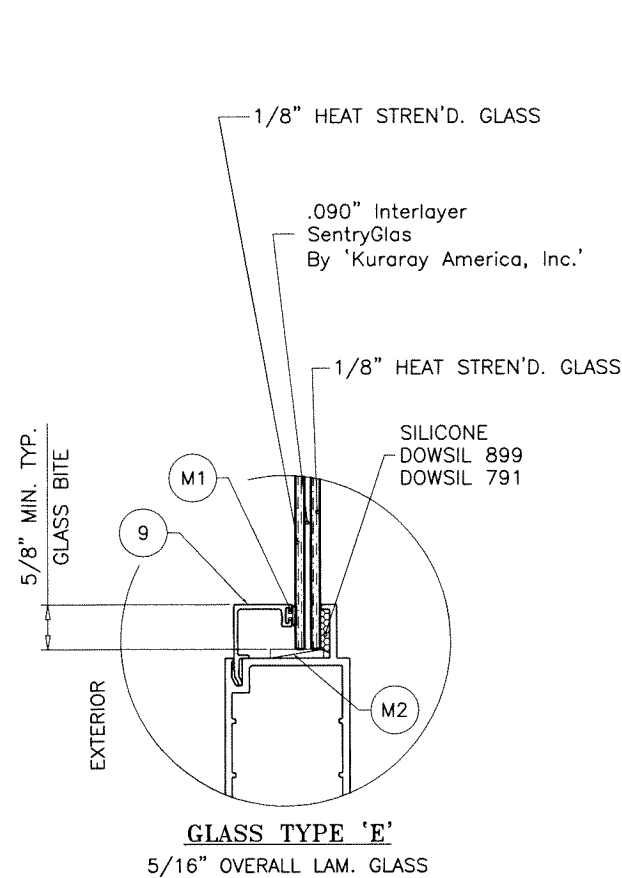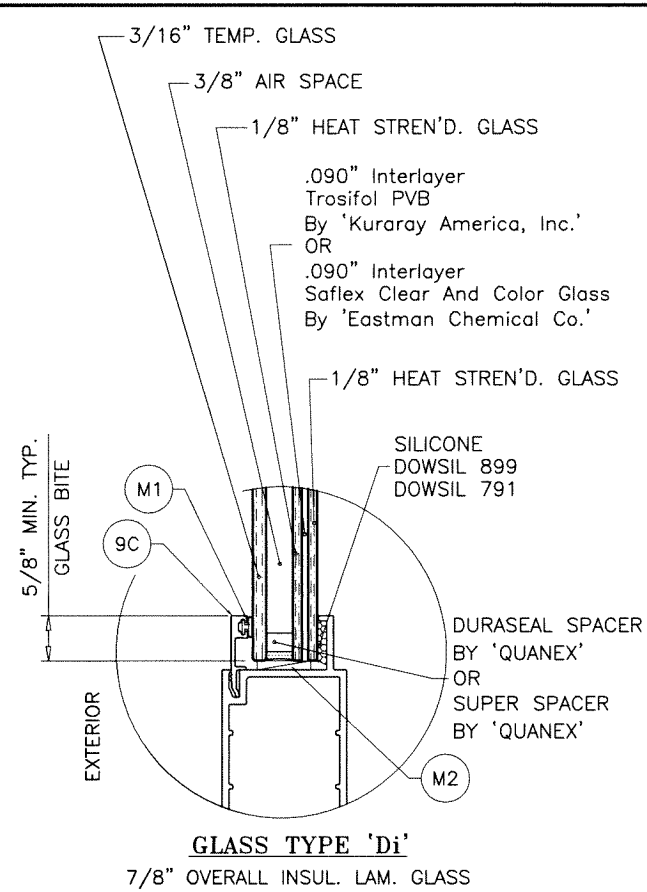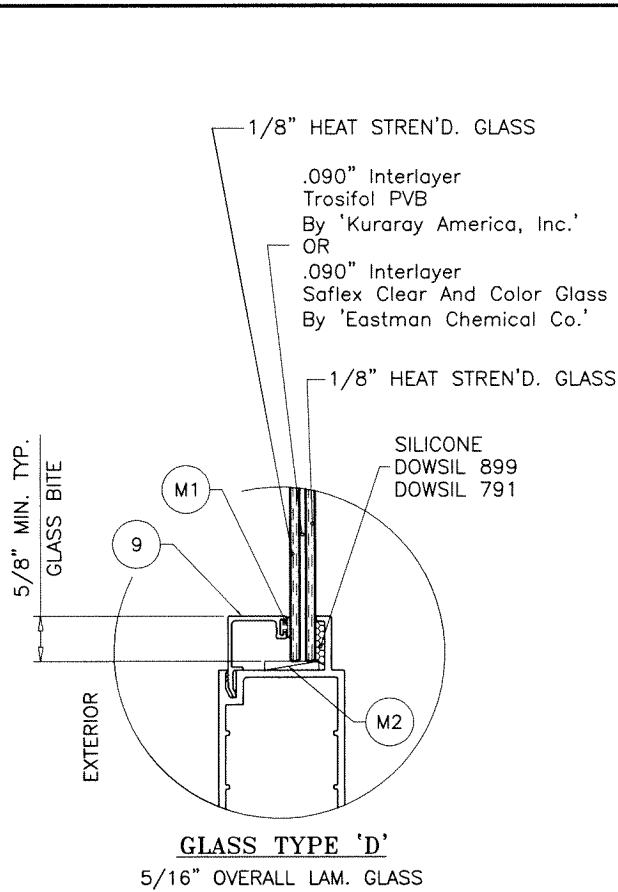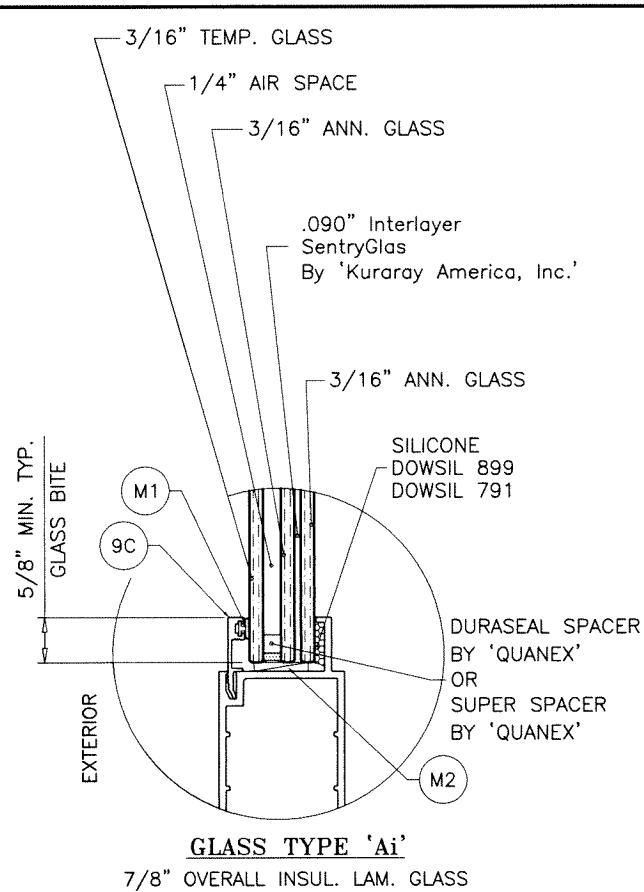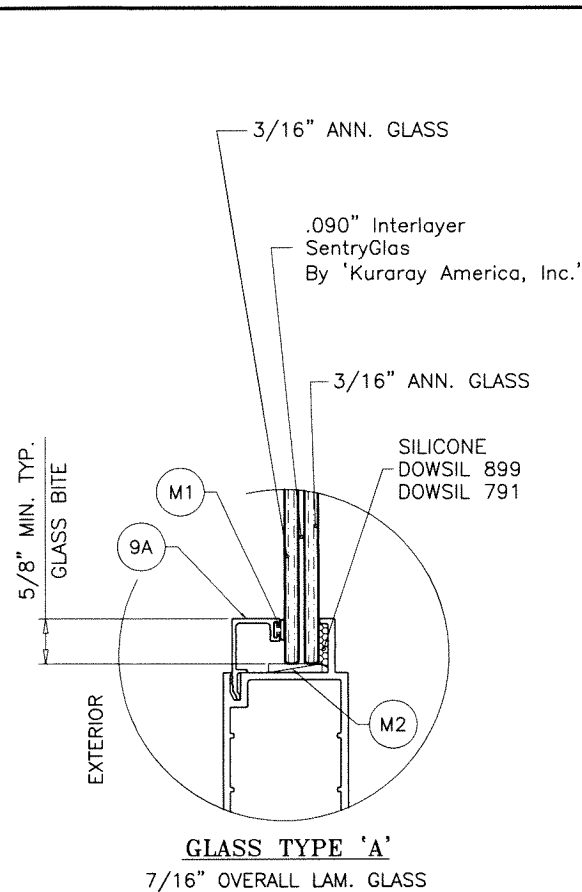

Sealed: 10/22/2024

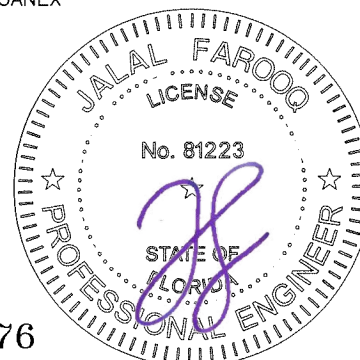

FL #46976

AL-FAROOQ CORPORATION
ENGINEERS & PRODUCT DEVELOPMENT
9360 SUNSET DRIVE, SUITE 220
MIAMI, FLORIDA 33173
TEL. (305) 264-8100 FAX. (305) 262-6978
COMP-ANL\21-14F-LI

Custom Window Systems Inc.
1900 S.W. 44th Avenue
Ocala, FL 34474
Tel. (352) 368-6922
WWW.CWS.CO

revisions:	
no	date by description

date: 02-22-21







scale: 3/8" = 1"

dr. by: TARIQ


chk. by:

drawing no.
21-14F

sheet 2 of 15

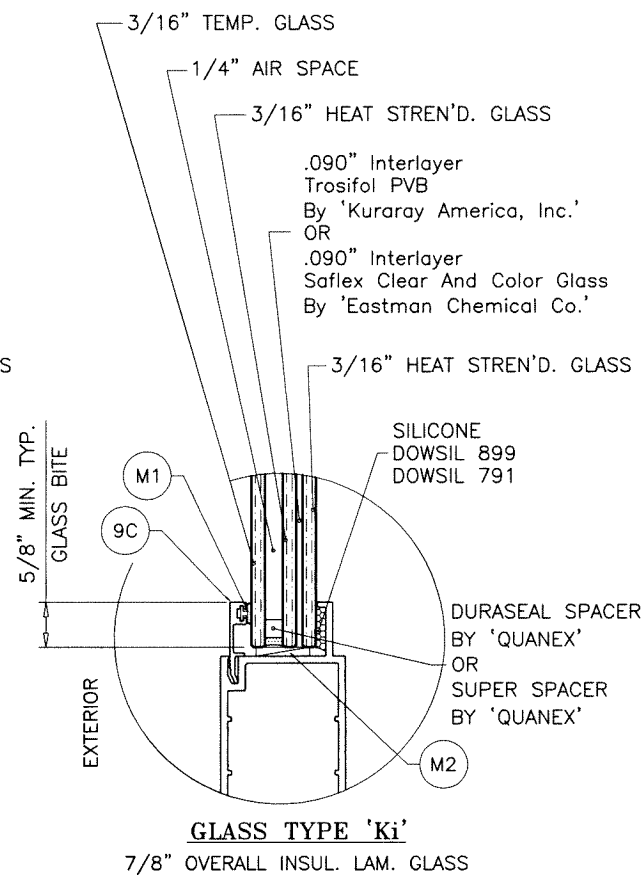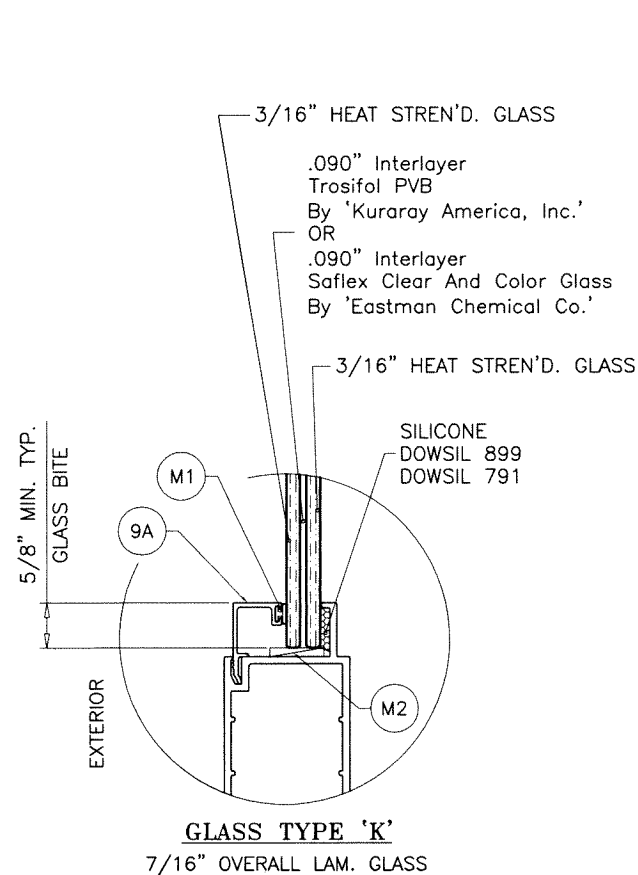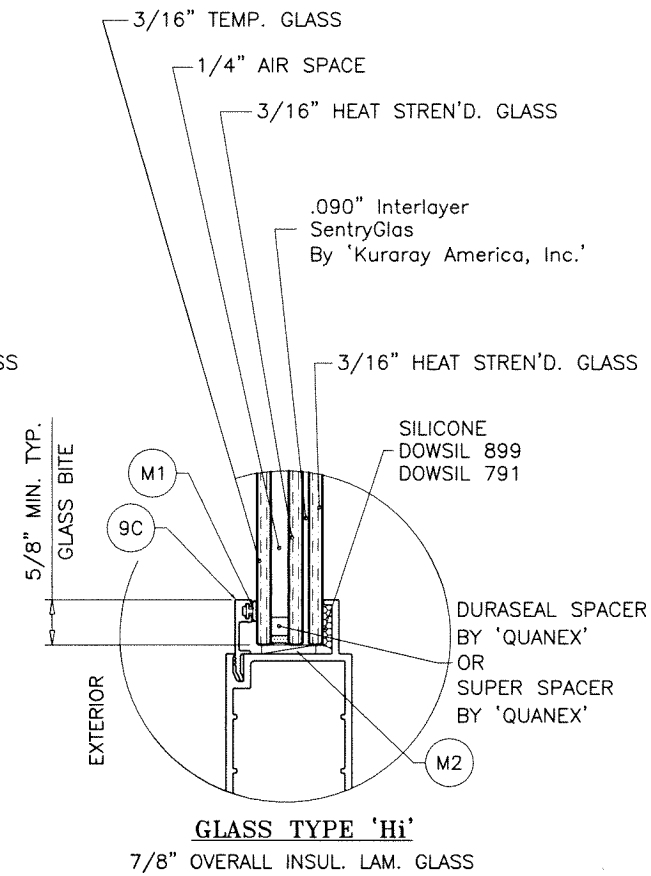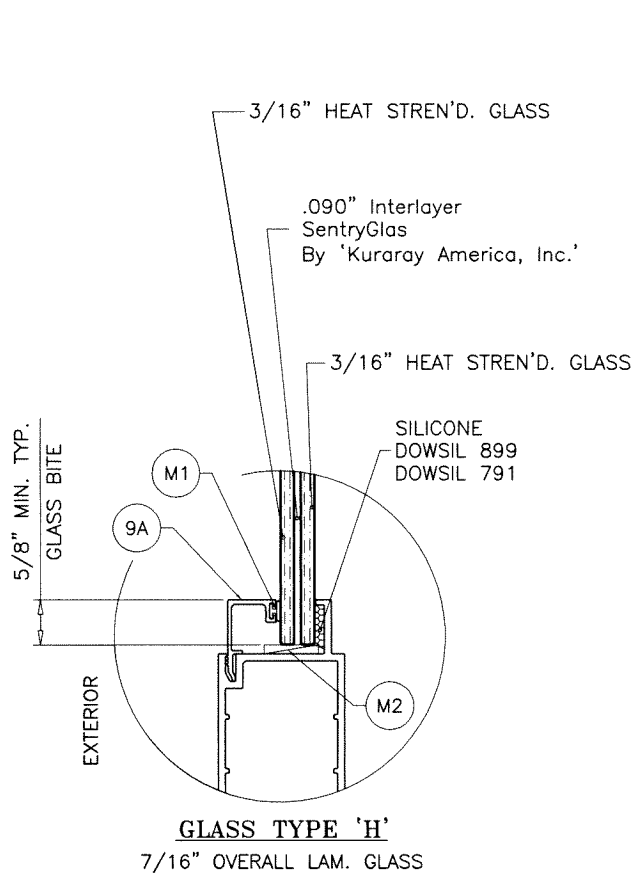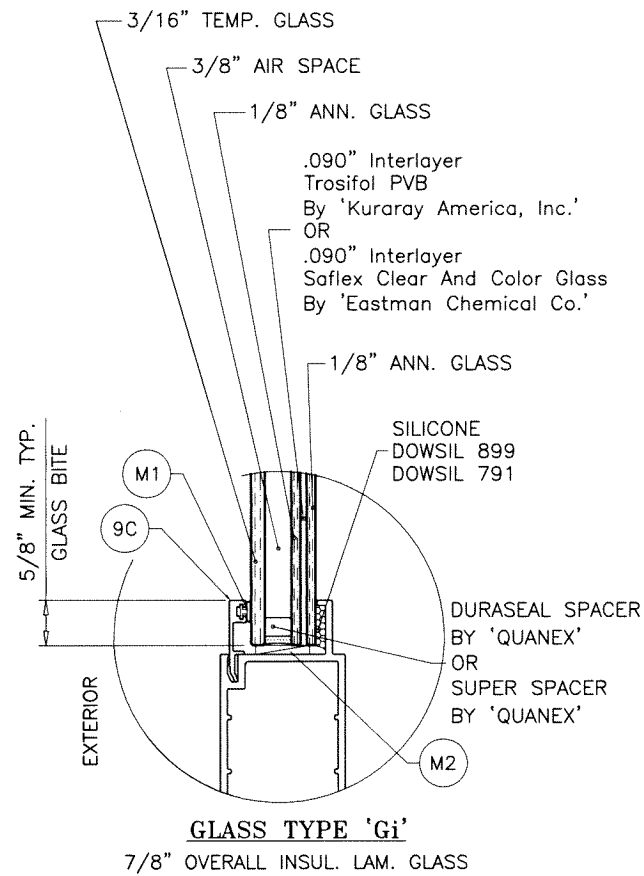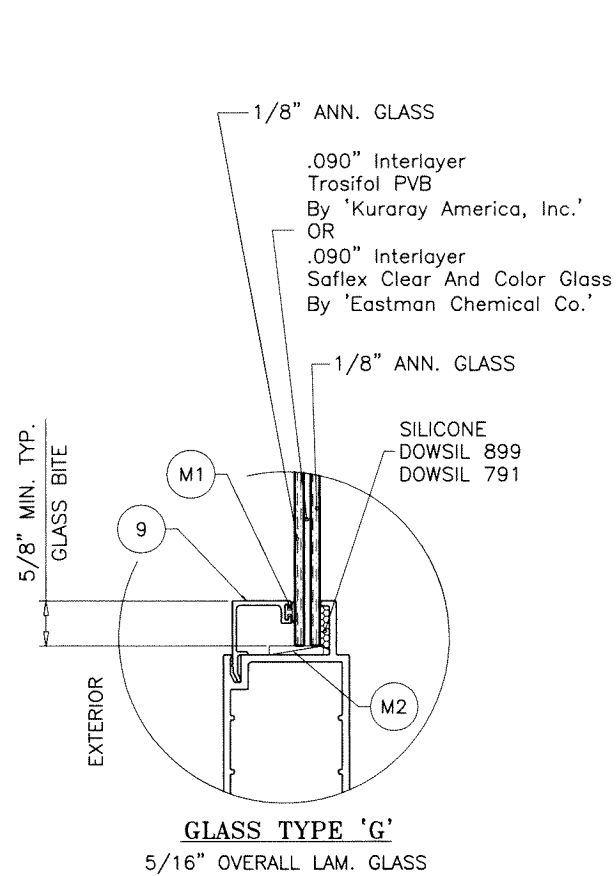

Sealed: 10/22/2024

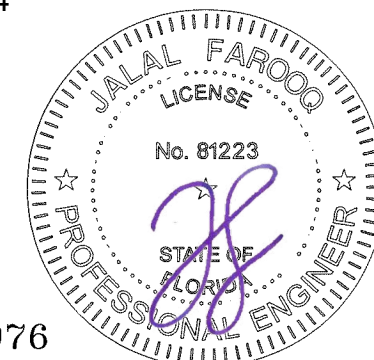

FL #46976

AL-FAROOQ CORPORATION
ENGINEERS & PRODUCT DEVELOPMENT
9360 SUNSET DRIVE, SUITE 220
MIAMI, FLORIDA 33173
TEL. (305) 264-8100 FAX. (305) 262-6978
COMP-ANL\21-14F-LI

Custom Window Systems Inc.
1900 S.W. 44th Avenue
Ocala, FL 34474
Tel. (352) 368-6922
WWW.CWS.CO

revisions:	
no	date by description

date: 02-22-21


scale: 3/8" = 1"

dr. by: TARIQ

chk. by:

drawing no.
21-14F

sheet 2.1 of 15

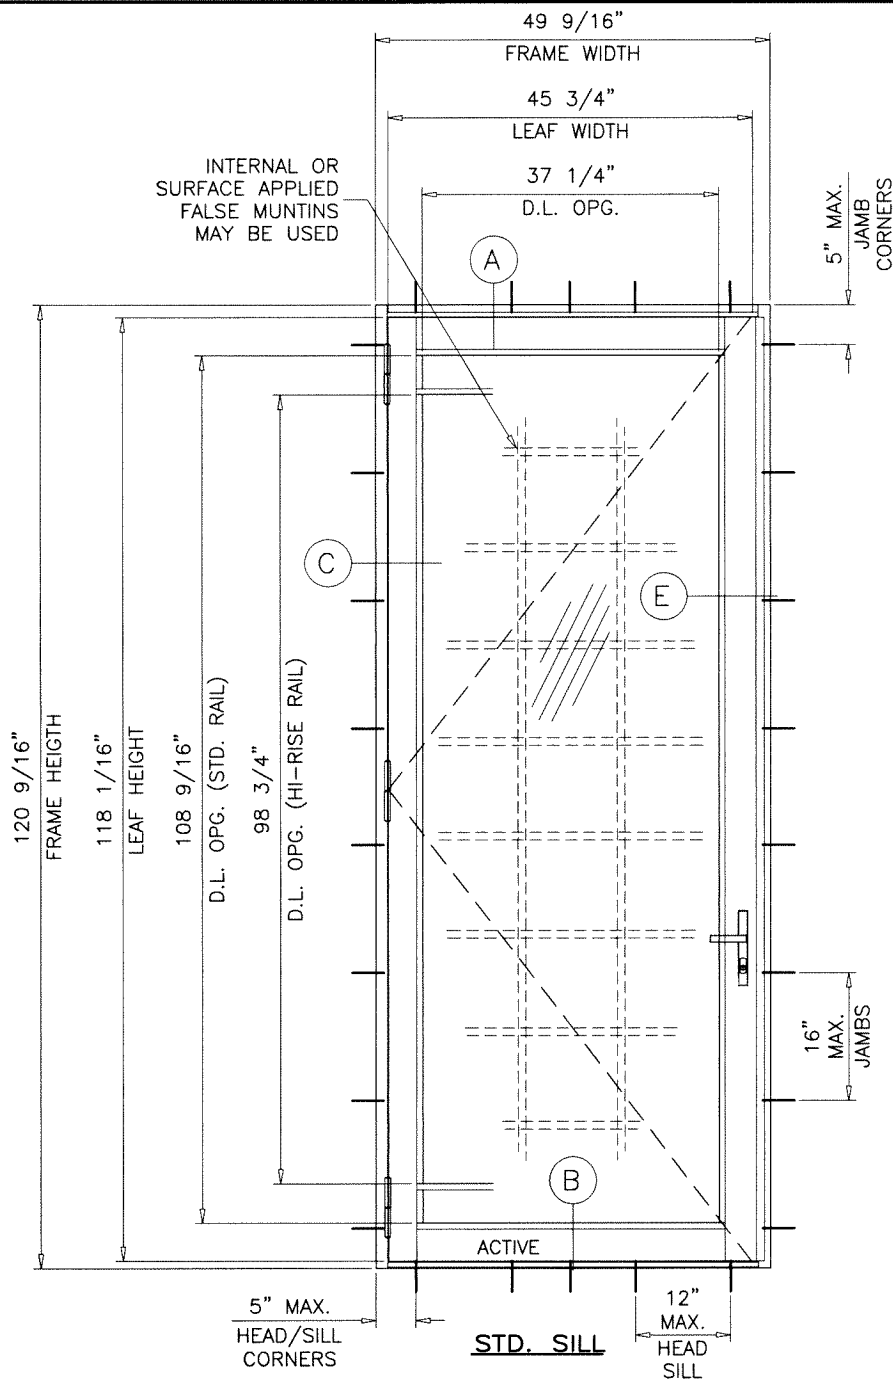

TYPICAL ELEVATION
(X)


SINGLE DOORS LOAD CAPACITY - PSF

FRAME		LEAF		THRESHOLD TYPES	GLASS TYPES 'A', 'Ai', 'H', 'Hi'		GLASS TYPES 'D', 'Di', 'E', 'Ei' 'F', 'Fi', 'K', 'Ki'		GLASS TYPE 'G'		GLASS TYPE 'Gi'	
					EXT.(+)	INT.(-)	EXT.(+)	INT.(-)	EXT.(+)	INT.(-)	EXT.(+)	INT.(-)
39-9/6"	80-9/16"	35-3/4"	78-1/16"	STD.	55.0	55.0	75.0	80.0	60.0	60.0	70.0	70.0
			78-9/16"	ADA								
39-9/6"	96"	35-3/4"	93-1/2"	STD.	55.0	55.0	75.0	80.0	-	-	-	-
			94"	ADA								
49-9/16"	120-9/16"	45-3/4"	118-1/16"	STD.	55.0	55.0	-	-	-	-	-	-
			118-9/16"	ADA								

NOTE:
GLASS CAPACITIES ON THIS SHEET ARE
BASED ON ASTM E1300-09 (3 SEC. GUSTS)
AND FLORIDA BUILDING COMMISSION
DECLARATORY STATEMENT DCA05-DEC-219

DOOR D.L.O. FORMULAE:
D.L.O. WIDTH = FRAME WIDTH - 12.3125" (X DOORS)
= (FRAME WIDTH - 21.50")/2 (XX DOORS)
D.L.O. HEIGHT = FRAME HEIGHT - 12.0" (STD. BOT. RAIL) (STD. SILL)
= FRAME HEIGHT - 16.875" (HI-RISE BOT. RAIL) (STD. SILL)
D.L.O. HEIGHT = FRAME HEIGHT - 11.50" (STD. BOT. RAIL) (ADA SILL)
= FRAME HEIGHT - 16.375" (HI-RISE BOT. RAIL) (ADA SILL)

Sealed: 10/22/2024

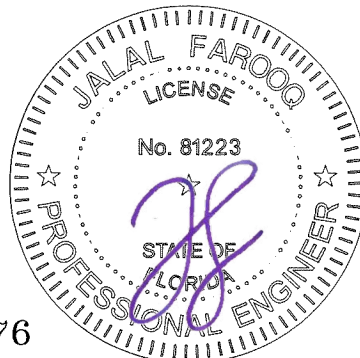

FL #46976

af c
AL-FAROOQ CORPORATION
ENGINEERS & PRODUCT DEVELOPMENT
9360 SUNSET DRIVE, SUITE 220
MIAMI, FLORIDA 33173 (C.A.N. 3538)
TEL. (305) 264-8100 FAX. (305) 262-6978

SERIES 7600 ALUMINUM OUTSWING DOOR (L.M.I.)

Custom Window Systems Inc.

1900 S.W. 44th Avenue
Ocala, FL 34474

Tel. (352) 368-6922

WWW.CWS.CC





revisions:	
no	description

date: 02-22-21	scale: 1/2"=1'-0"
dr. by: TARIQ	chk. by:

drawing no.
21-14F
sheet 3 of 15


COMP-ANL\21-14F-LI

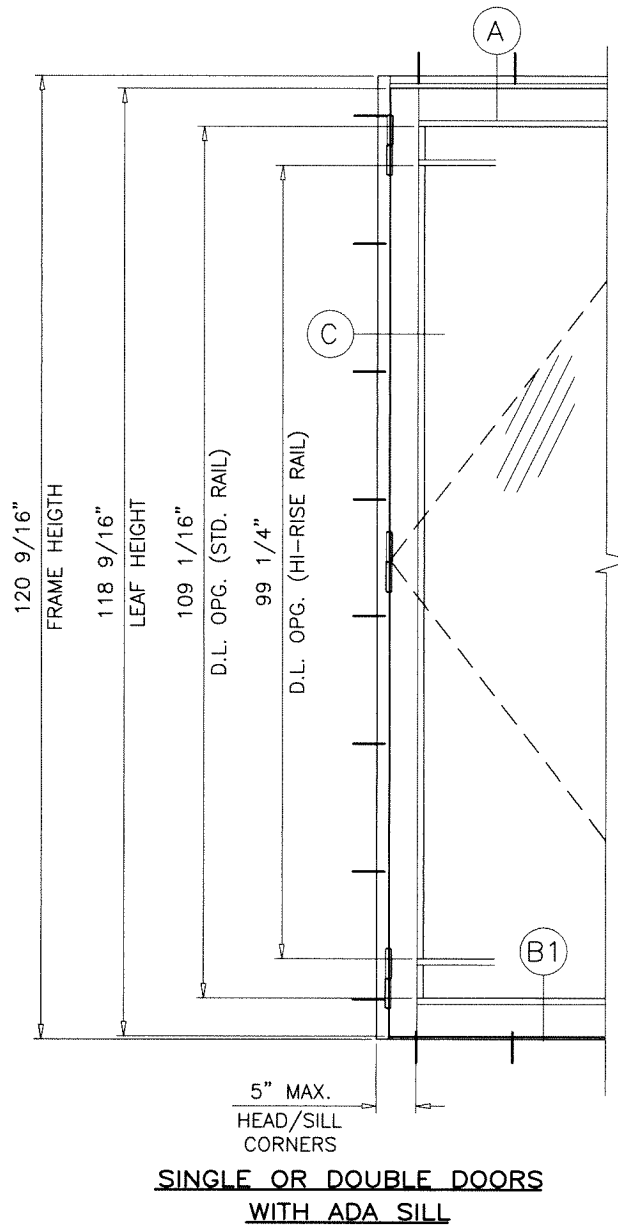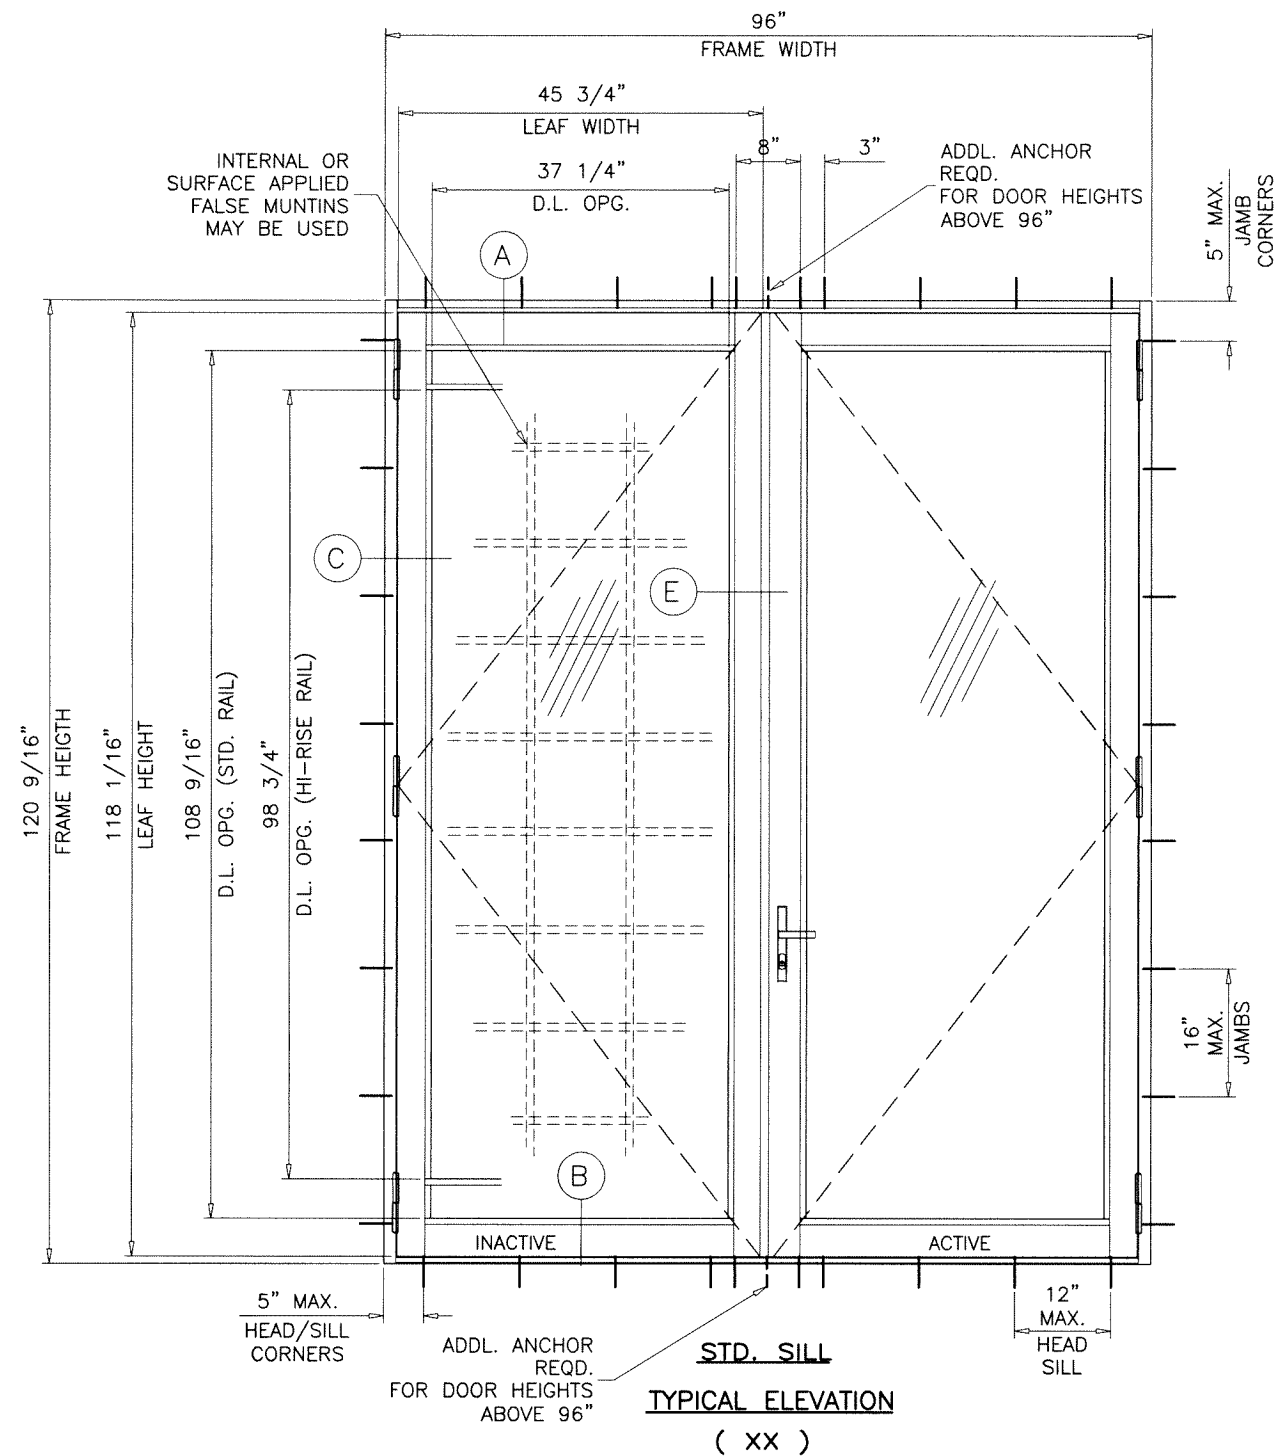

DOUBLE DOORS LOAD CAPACITY - PSF												
FRAME		LEAF		THRESHOLD TYPES	GLASS TYPES 'A','Ai','H','Hi'		GLASS TYPES 'D','Di','E','Ei' 'F','Fi','K','Ki'		GLASS TYPES 'G'		GLASS TYPES 'Gi'	
					EXT.(+)	INT.(−)	EXT.(+)	INT.(−)	EXT.(+)	INT.(−)	EXT.(+)	INT.(−)
WIDTH	HEIGHT	WIDTH	HEIGHT									
76"	80–9/16"	35–3/4"	78–1/16"	STD.	55.0	55.0	75.0	80.0	60.0	60.0	70.0	70.0
			78–9/16"	ADA								
76"	96"	35–3/4"	93–1/2"	STD.	55.0	55.0	75.0	80.0	—	—	—	—
			94"	ADA								
96"	120–9/16"	45–3/4"	118–1/16"	STD.	55.0	55.0	—	—	—	—	—	—
			118–9/16"	ADA								

NOTE:
GLASS CAPACITIES ON THIS SHEET ARE
BASED ON ASTM E1300-09 (3 SEC. GUSTS)
AND FLORIDA BUILDING COMMISSION
DECLARATORY STATEMENT DCA05-DEC-219

Sealed: 10/22/2024

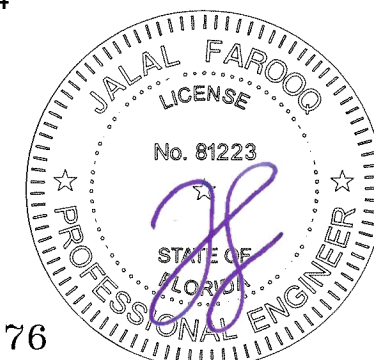

AL-FAROOQ CORPORATION
ENGINEERS & PRODUCT DEVELOPMENT
9360 SUNSET DRIVE, SUITE 220
MIAMI, FLORIDA 33173
TEL. (305) 264-8100 FAX. (305) 262-6978

COMP-ANL\21-14F-LI

SERIES 7600 ALUMINUM OUTSWING DOOR (L.M.I.)

Custom Window Systems Inc.
1900 S.W. 44th Avenue
Ocala, FL 34474
Tel. (352) 368-6922


CWS

WWW.CWS.CC



revisions:		no	date	by	description

date: 02-22-21	scale: 1/2"=1'-0"	dr. by: TARIQ	chk. by:	drawing no.	no.
				21-14F	
				sheet 3.1 of 15	

FL #46976

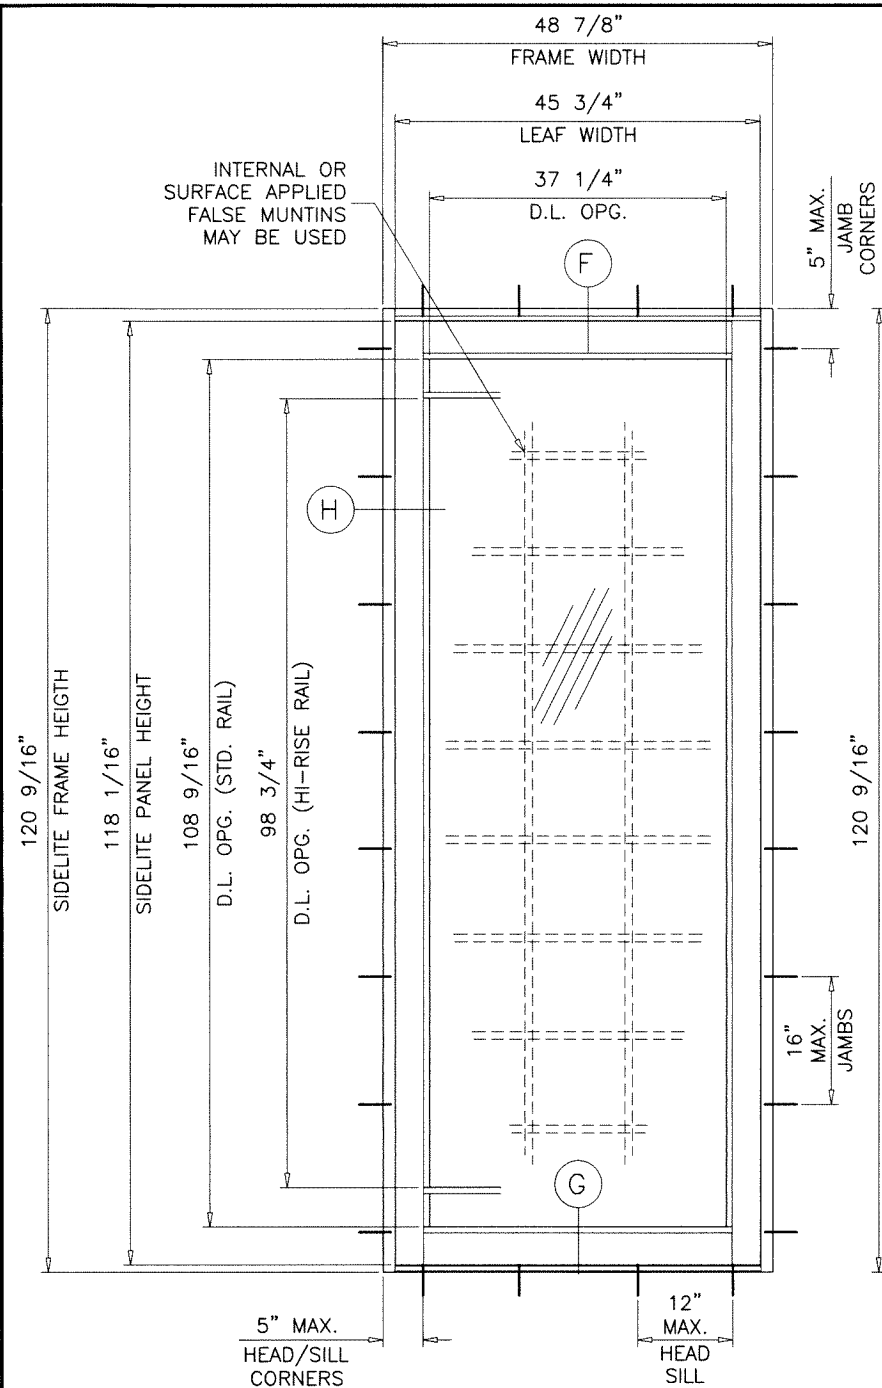

TYPICAL ELEVATION
(O)

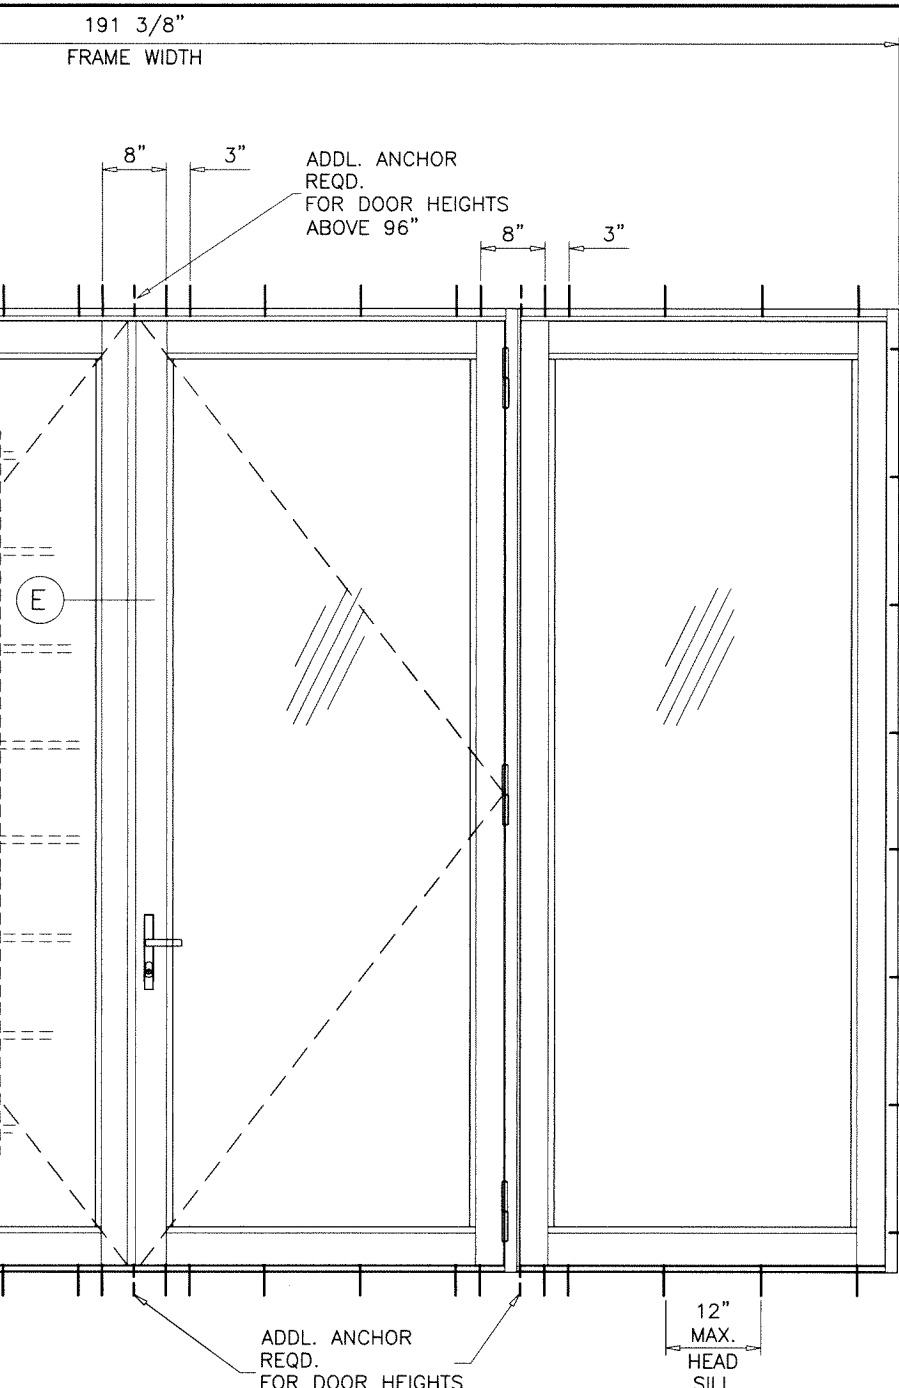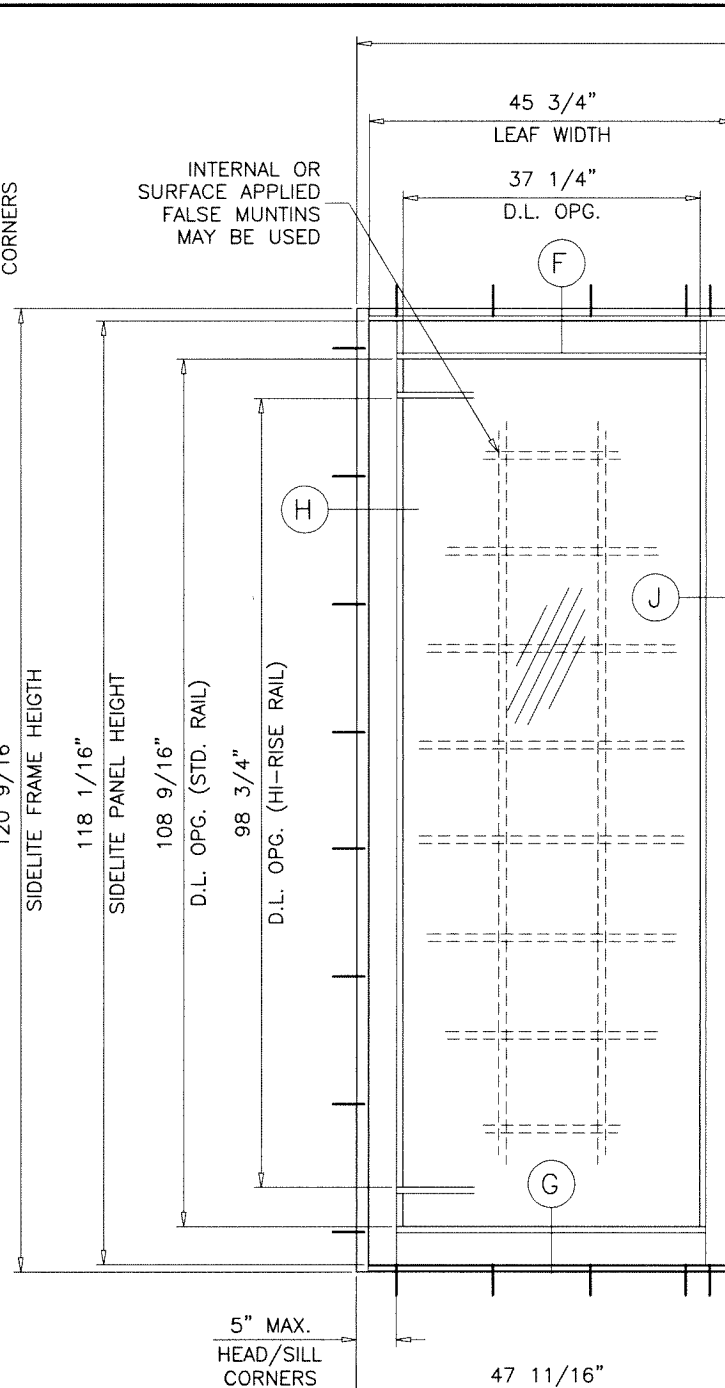

TYPICAL ELEVATION
(O-XX-O)


NOTE:
THE FRAME AREA OF ALTERNATE SIZE MUST NOT
EXCEED TESTED FRAME AREA = 160.2 SQ. FT.

SIDELITE LOAD CAPACITY – PSF OR STAND ALONE STATIONARY PANEL (O)												
FRAME		PANEL		THRESHOLD TYPES	GLASS TYPES 'A', 'Ai', 'H', 'Hi'		GLASS TYPES 'D', 'Di', 'E', 'Ei' 'F', 'Fi', 'K', 'Ki'		GLASS TYPES 'G'		GLASS TYPES 'Gi'	
					EXT.(+)	INT.(–)	EXT.(+)	INT.(–)	EXT.(+)	INT.(–)	EXT.(+)	INT.(–)
38–7/8"	80–9/16"	35–3/4"	78–1/16"	STD.	55.0	55.0	75.0	80.0	60.0	60.0	70.0	70.0
			78–9/16"	ADA								
38–7/8"	96"	35–3/4"	93–1/2"	STD.	55.0	55.0	75.0	80.0	–	–	–	–
			94"	ADA								
48–7/8"	120–9/16"	45–3/4"	118–1/16"	STD.	55.0	55.0	–	–	–	–	–	–
			118–9/16"	ADA								

SIDELITE D.L.O. FORMULAE:
D.L.O. WIDTH = FRAME WIDTH - 11.625"
D.L.O. HEIGHT = FRAME HEIGHT - 12.0" (STD. BOT. RAIL) (STD. SILL)
= FRAME HEIGHT - 16.875" (HI-RISE BOT. RAIL) (STD. SILL)
D.L.O. HEIGHT = FRAME HEIGHT - 11.5" (STD. BOT. RAIL) (ADA. SILL)
= FRAME HEIGHT - 16.375" (HI-RISE BOT. RAIL) (ADA. SILL)

Sealed: 10/22/2024

FL #46976

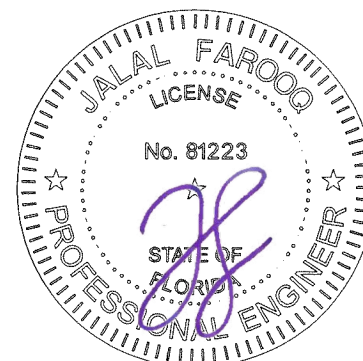

AL-FAROOQ CORPORATION
ENGINEERS & PRODUCT DEVELOPMENT
9360 SUNSET DRIVE, SUITE 220
MIAMI, FLORIDA 33173
TEL. (305) 264-8100 FAX. (305) 262-6978

SERIES 7600 ALUMINUM OUTSWING DOOR (L.M.I.)

Custom Window Systems Inc.
1900 S.W. 44th Avenue
Ocala, FL. 34474
Tel. (352) 368-6922

www.cws.cc

revisions:


no	date	by	description

date: 02-22-21
scale: 1/2"=1'-0"
dr. by: TARIQ
chk. by:

drawing no.
21-14F


sheet **4** of **15**

DESIGN LOAD CAPACITY - PSF							
DOOR TO SIDELITE MULLION							
SIDELITE WIDTH INCHES	FRAME HEIGHT INCHES	MULL 'M1'		MULL 'M2'		MULL 'M3'	
		EXT.(+)	INT.(-)	EXT.(+)	INT.(-)	EXT.(+)	INT.(-)
24	80-9/16	75.0	80.0	75.0	80.0	75.0	80.0
30		75.0	80.0	75.0	80.0	75.0	80.0
36		75.0	77.2	75.0	80.0	75.0	80.0
42		71.4	71.4	75.0	80.0	75.0	80.0
47-11/16		66.6	66.6	75.0	80.0	75.0	80.0
24	84	75.0	80.0	75.0	80.0	75.0	80.0
30		74.1	74.1	75.0	80.0	75.0	80.0
36		68.1	68.1	75.0	80.0	75.0	80.0
42		63.0	63.0	75.0	80.0	75.0	80.0
47-11/16		58.8	58.8	75.0	80.0	75.0	80.0
24	90	66.1	66.1	75.0	80.0	75.0	80.0
30		60.2	60.2	75.0	80.0	75.0	80.0
36		55.3	55.3	75.0	78.2	75.0	80.0
42		51.2	51.2	73.0	73.0	75.0	80.0
47-11/16		-	-	68.8	68.8	75.0	80.0
24	96	48.8	48.8	74.9	74.9	75.0	80.0
30		44.8	44.8	69.3	69.3	75.0	80.0
36		43.8	43.8	64.4	64.4	75.0	80.0
42		-	-	60.2	60.2	75.0	80.0
47-11/16		-	-	56.7	56.7	75.0	80.0
24	102	-	-	55.0	55.0	55.0	55.0
30		-	-	55.0	55.0	55.0	55.0
36		-	-	53.7	53.7	55.0	55.0
42		-	-	50.2	50.2	55.0	55.0
47-11/16		-	-	47.2	47.2	55.0	55.0
24	108	-	-	52.6	52.6	55.0	55.0
30		-	-	48.6	48.6	55.0	55.0
36		-	-	45.2	45.2	55.0	55.0
42		-	-	42.3	42.3	55.0	55.0
47-11/16		-	-	39.8	39.8	55.0	55.0
24	114	-	-	44.7	44.7	55.0	55.0
30		-	-	41.4	41.4	55.0	55.0
36		-	-	38.5	38.5	55.0	55.0
42		-	-	35.9	35.9	55.0	55.0
47-11/16		-	-	33.8	33.8	54.7	54.7
24	120	-	-	37.8	37.8	55.0	55.0
30		-	-	35.0	35.0	55.0	55.0
36		-	-	32.5	32.5	52.6	52.6
42		-	-	30.4	30.4	49.1	49.1
47-11/16		-	-	28.6	28.6	47.0	47.0

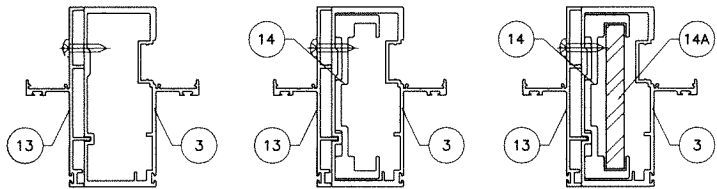

MULLION 'M1' MULLION 'M2' MULLION 'M3'

DOOR TO SIDELITE MULLION

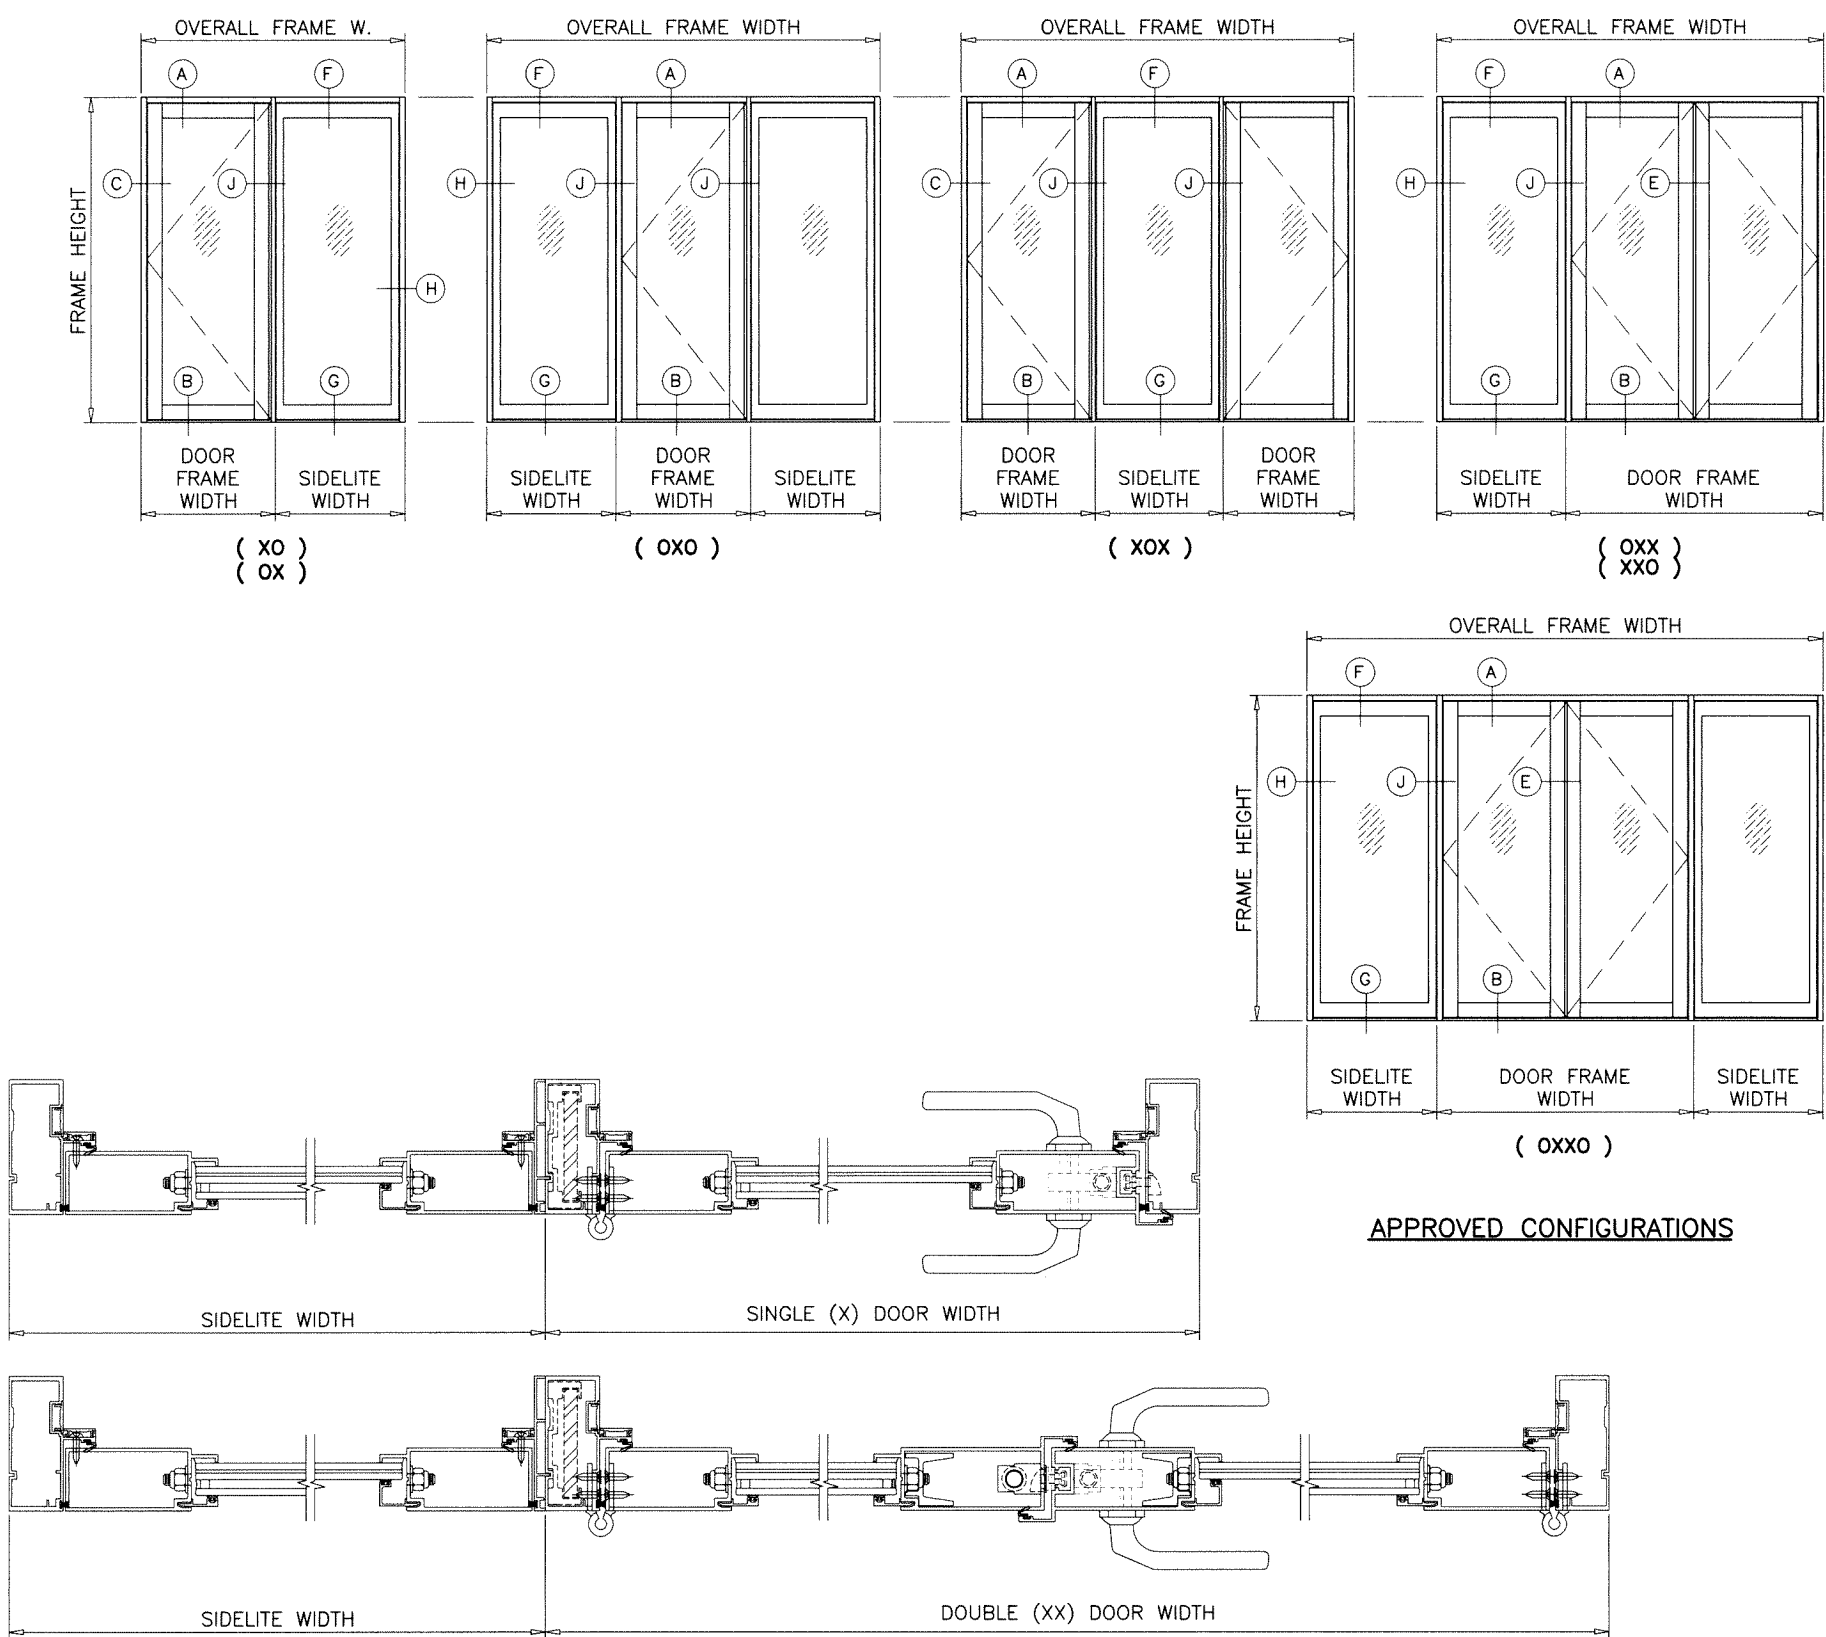

APPROVED CONFIGURATIONS

Sealed: 10/22/2024



NOTE:
FOR DOORS CAPACITY SEE SHEETS 3 & 3.1.
FOR SIDELITE CAPACITIES SEE SHEET 4.
FOR SIDELITE MULLION CAPACITY SEE CHART ABOVE
LOWER VALUES FROM DOORS, SIDELITE, DOOR/SIDELITE
OR DOOR/DOOR MULLION CHART WILL APPLY TO ENTIRE SYSTEM.

FL #46976

AL-FAROOQ CORPORATION
ENGINEERS & PRODUCT DEVELOPMENT
9360 SUNSET DRIVE, SUITE 220
MIAMI, FLORIDA 33173
TEL. (305) 264-8100
FAX. (305) 262-6978
(C.A.N. 3538)

COMP-ANL 21-14F-LI

SERIES 7600 ALUMINUM OUTSWING DOOR (L.M.I.)

Custom Window Systems Inc.
1900 S.W. 44th Avenue
Ocala, FL. 34474
Tel. (352) 368-6922
www.cws.cc

revisions:

no	date	by	description

date: 02-22-21

scale: -


dr. by: TARIQ

chk. by:


drawing no.

21-14F

sheet 5 of 15

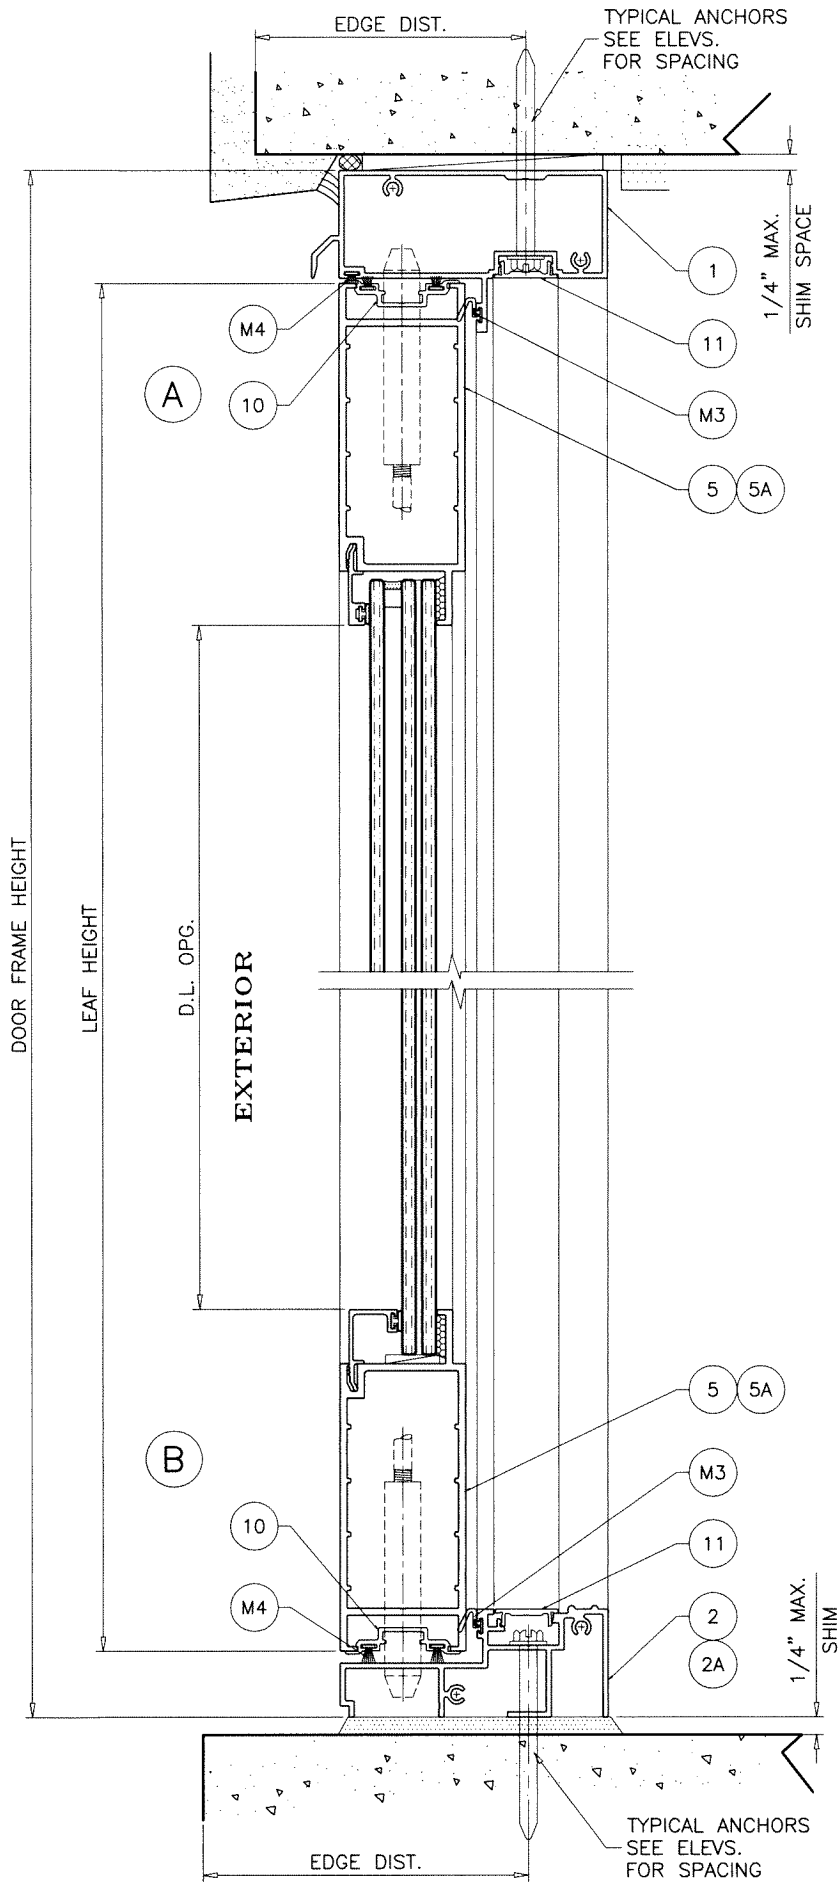


STD. THRESHOLD
APPROVED FOR WATER INFILTRATION RESISTANCE

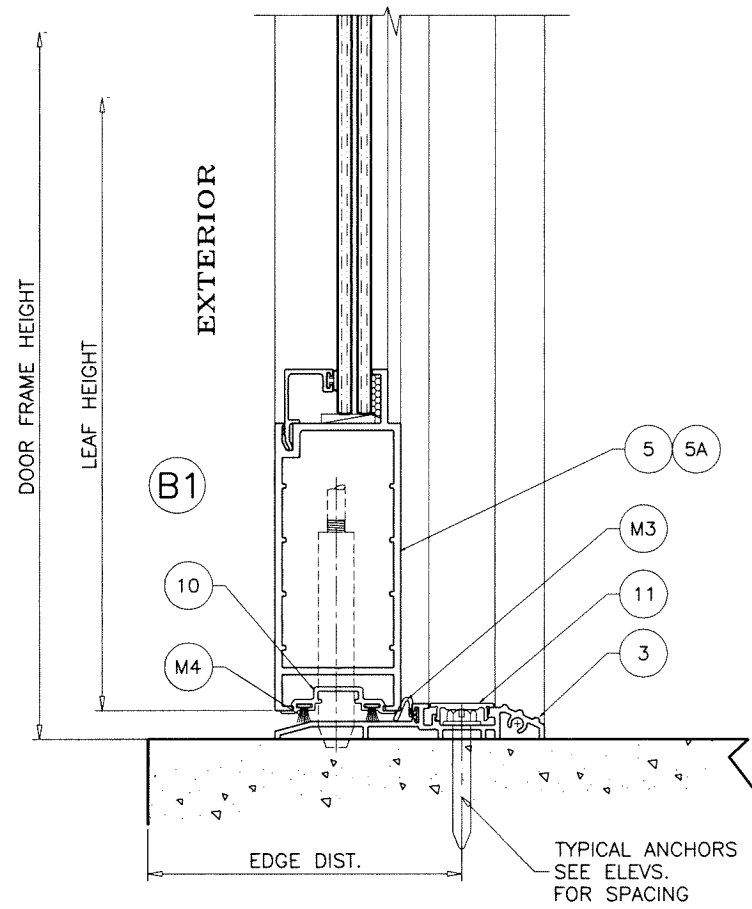

ADA THRESHOLD
NOT APPROVED FOR WATER INFILTRATION RESISTANCE





Sealed: 10/22/2024

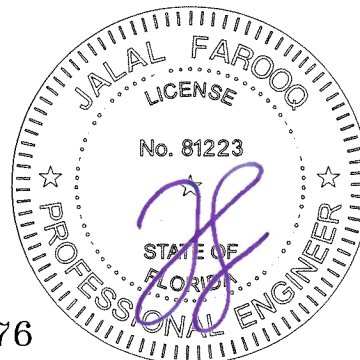

DOOR DETAILS

AL-FAROOQ CORPORATION ENGINEERS & PRODUCT DEVELOPMENT 9360 SUNSET DRIVE, SUITE 220 MIAMI, FLORIDA 33173 TEL. (305) 264-8100 FAX. (305) 262-6978 (C.A.N. 3538)		COMP-ANL\21-14F-LI
SERIES 7600 ALUMINUM OUTSWING DOOR (L.M.I.)		
Custom Window Systems Inc. 1900 S.W. 44th Avenue Ocala, FL. 34474 Tel. (352) 368-6922 www.cws.cc		
revisions: no. date by description	date: 02-22-21 scale: 3/8" = 1" dr. by: TARIQ chg. by:	
drawing no. 21-14F		
sheet 6 of 15		

FL #46976

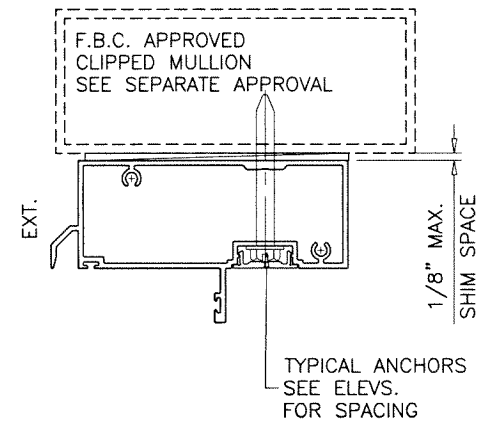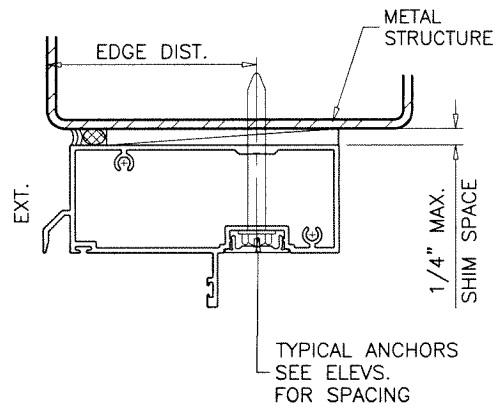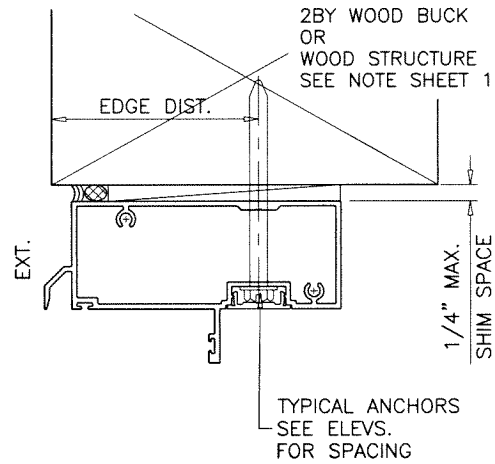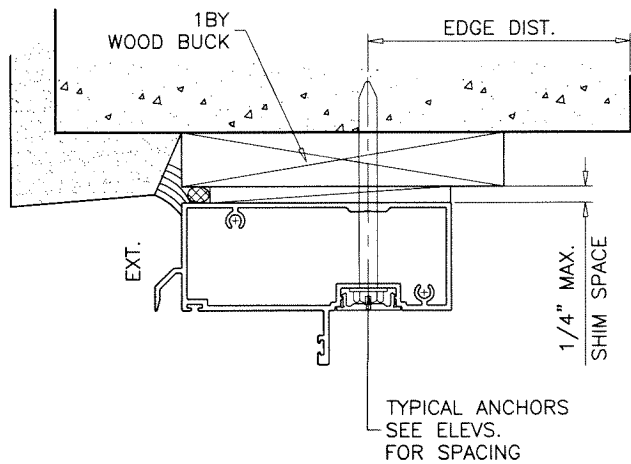

WOOD BUCKS AND METAL STRUCTURE NOT BY 'CUSTOM WINDOW SYS.' MUST SUSTAIN LOADS IMPOSED BY GLAZING SYSTEM AND TRANSFER THEM TO THE BUILDING STRUCTURE.

TYPICAL ANCHORS: SEE ELEV. FOR SPACING

1/4" DIA. ULTRACON+ BY 'DEWALT' (Fu=164 KSI, Fy=148 KSI)

INTO 2BY WOOD BUCKS OR WOOD STRUCTURES
1-1/2" MIN. PENETRATION INTO WOOD (HEAD/JAMBS)

THRU 1BY BUCKS INTO CONC. OR BLOCKS
1-3/4" MIN. EMBED INTO CONCRETE (HEAD/JAMBS)
1-1/4" MIN. EMBED INTO BLOCKS (JAMBS)

DIRECTLY INTO CONCRETE OR GROUT FILLED BLOCKS
1-3/4" MIN. EMBED INTO CONCRETE (HEAD/SILL/JAMBS)
1-3/4" MIN. EMBED INTO GROUT-FILLED BLOCKS (JAMBS)

1/4" DIA. TEKS OR SELF DRILLING SCREWS (GRADE 5 CRS)

INTO F.B.C. APPROVED MULLIONS
OR
INTO METAL STRUCTURES (HEAD/JAMBS)
(3) THREADS MIN. PENETRATION BEYOND SUBSTRATE
ALUMINUM: 1/8" THK. MIN. (6063-T5 MIN.)
STEEL: 1/8" THK. MIN. (Fy = 36 KSI MIN.)
(STEEL IN CONTACT WITH ALUMINUM TO BE PLATED OR PAINTED)


TYPICAL EDGE DISTANCE

INTO CONCRETE AND MASONRY = 2-1/2" MIN.
INTO WOOD STRUCTURE = 1" MIN.
INTO METAL STRUCTURE = 3/4" MIN.

WOOD AT HEAD OR JAMBS SG = 0.55 MIN.
CONCRETE AT HEAD, SILL OR JAMBS f'c = 3000 PSI MIN.
C-90 GROUT FILLED BLOCK AT JAMBS f'm = 2000 PSI MIN.

Sealed: 10/22/2024

DOOR DETAILS

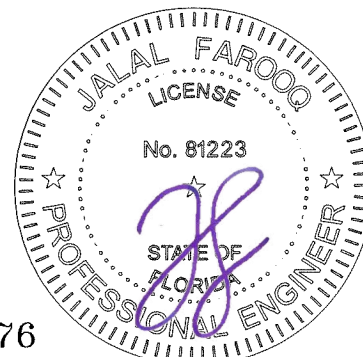

FL #46976

af c
AL-FAROOQ CORPORATION
ENGINEERS & PRODUCT DEVELOPMENT
9360 SUNSET DRIVE, SUITE 220 (C.A.N. 3538)
MIAMI, FLORIDA 33173 FAX. (305) 262-6978
TEL. (305) 264-8100

SERIES 7600 ALUMINUM OUTSWING DOOR (L.M.I.)

Custom Window Systems Inc.

1900 S.W. 44th Avenue
Ocala, FL. 34474

Tel. (352) 368-6922

www.cws.cc



revisions:		no	date	by	description




date: 02-22-21	scale: 3/8" = 1"	dr. by: TARIQ	chk. by:
----------------	------------------	---------------	----------

drawing no.

21-14F


sheet 7 of 15

COMP-ANL 21-14F-LI

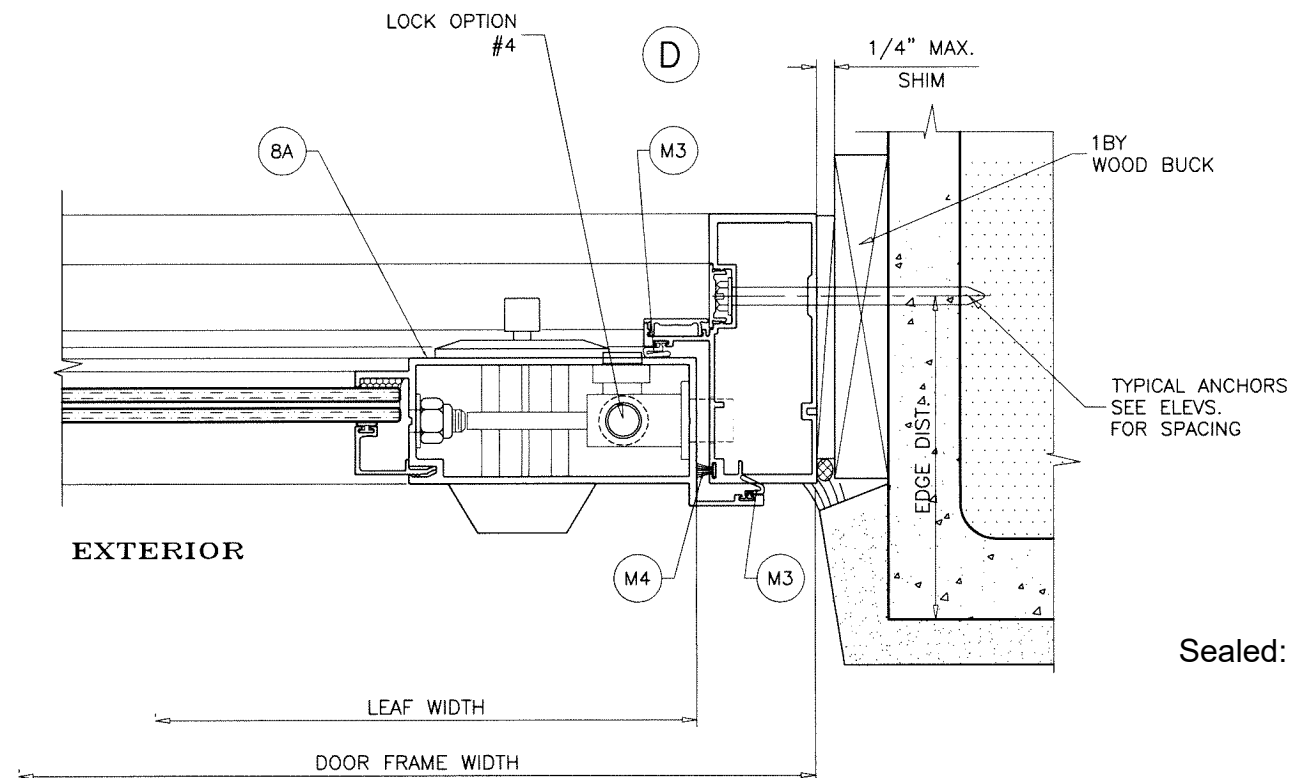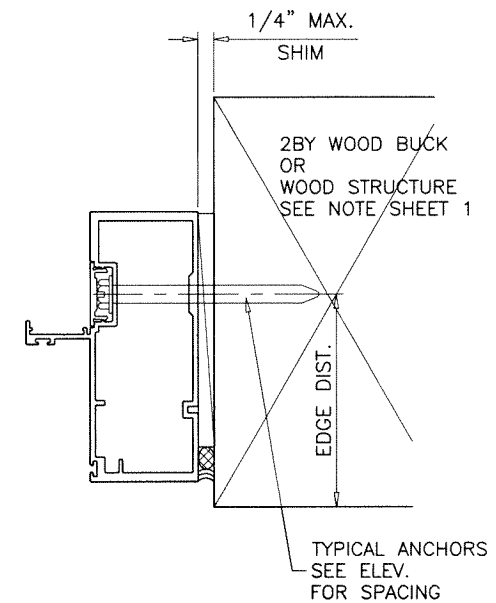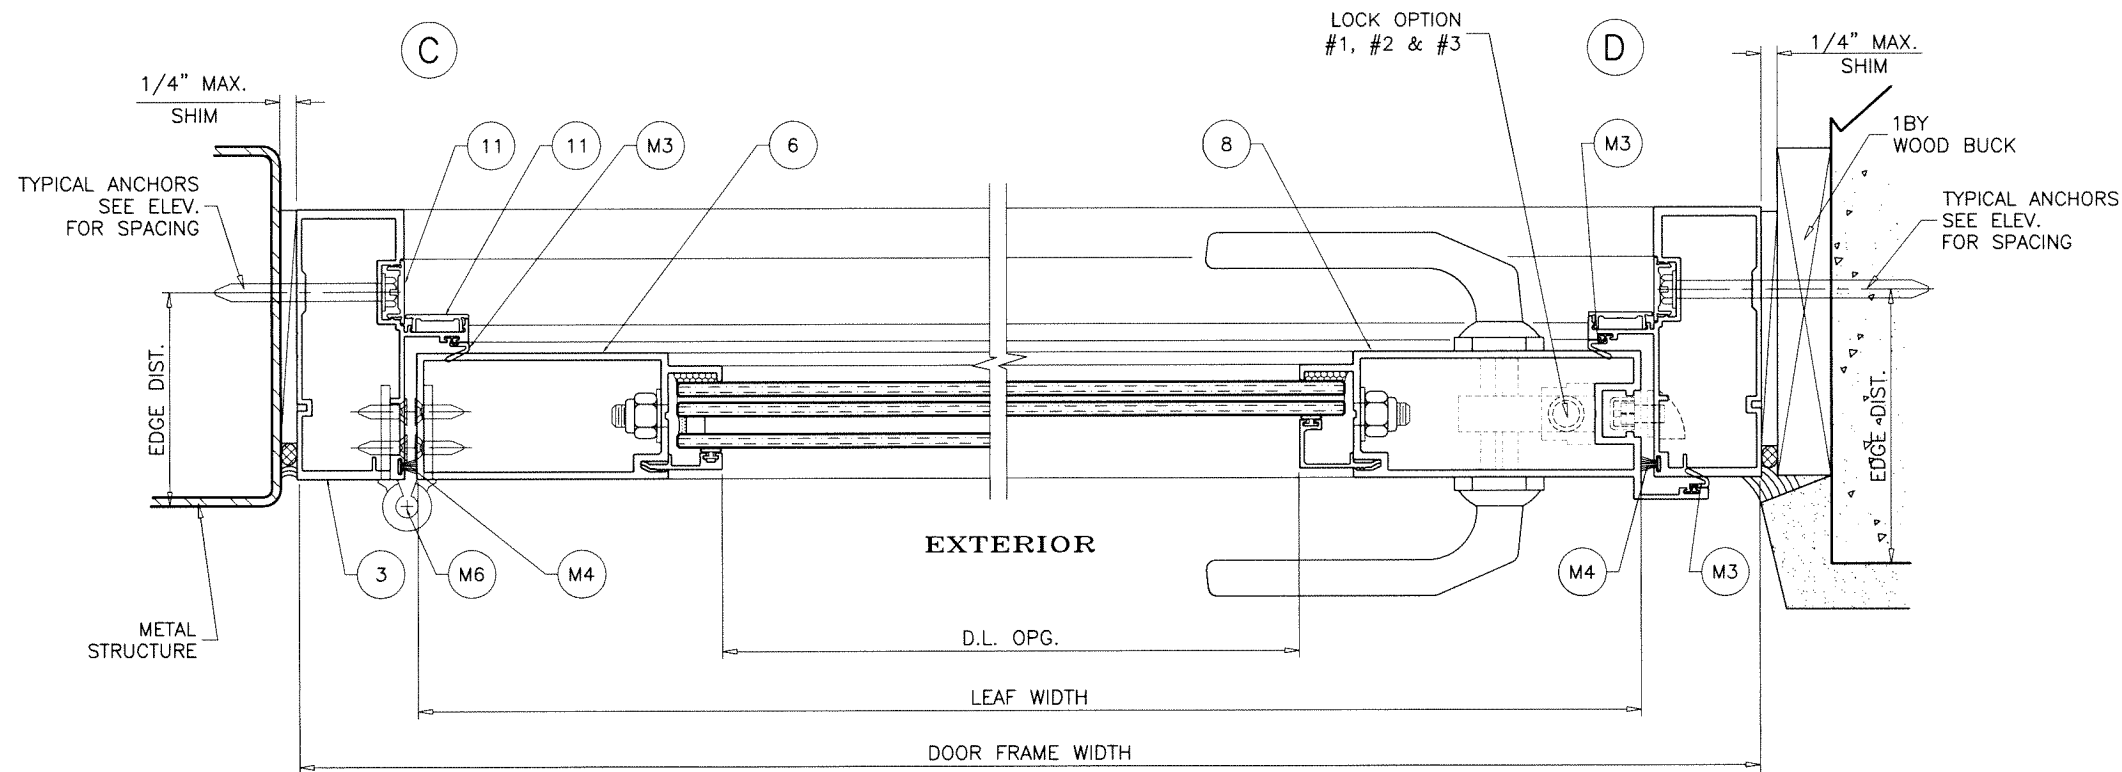

Sealed: 10/22/2024

DOOR DETAILS

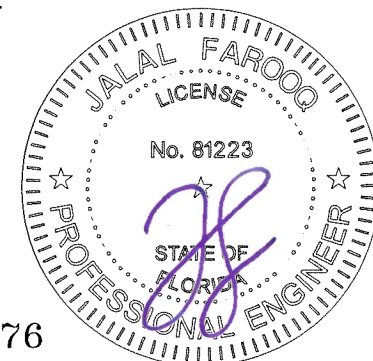

FL #46976

AL-FAROOQ CORPORATION
ENGINEERS & PRODUCT DEVELOPMENT
9360 SUNSET DRIVE, SUITE 220
MIAMI, FLORIDA 33173 (C.A.N. 3538)
TEL. (305) 264-8100 FAX. (305) 262-6978

COMP-ANL\21-14F-LI

SERIES 7600 ALUMINUM OUTSWING DOOR (L.M.I.)


Custom Window Systems Inc.
1900 S.W. 44th Avenue
Ocala, FL. 34474
Tel. (352) 368-6922

CWS


www.cws.cc

revisions:	
no	date by description

date: 02-22-21	scale: 3/8" = 1"	dr. by: TARIQ	chk. by:
drawing no. 21-14F			
sheet 8 of 15			

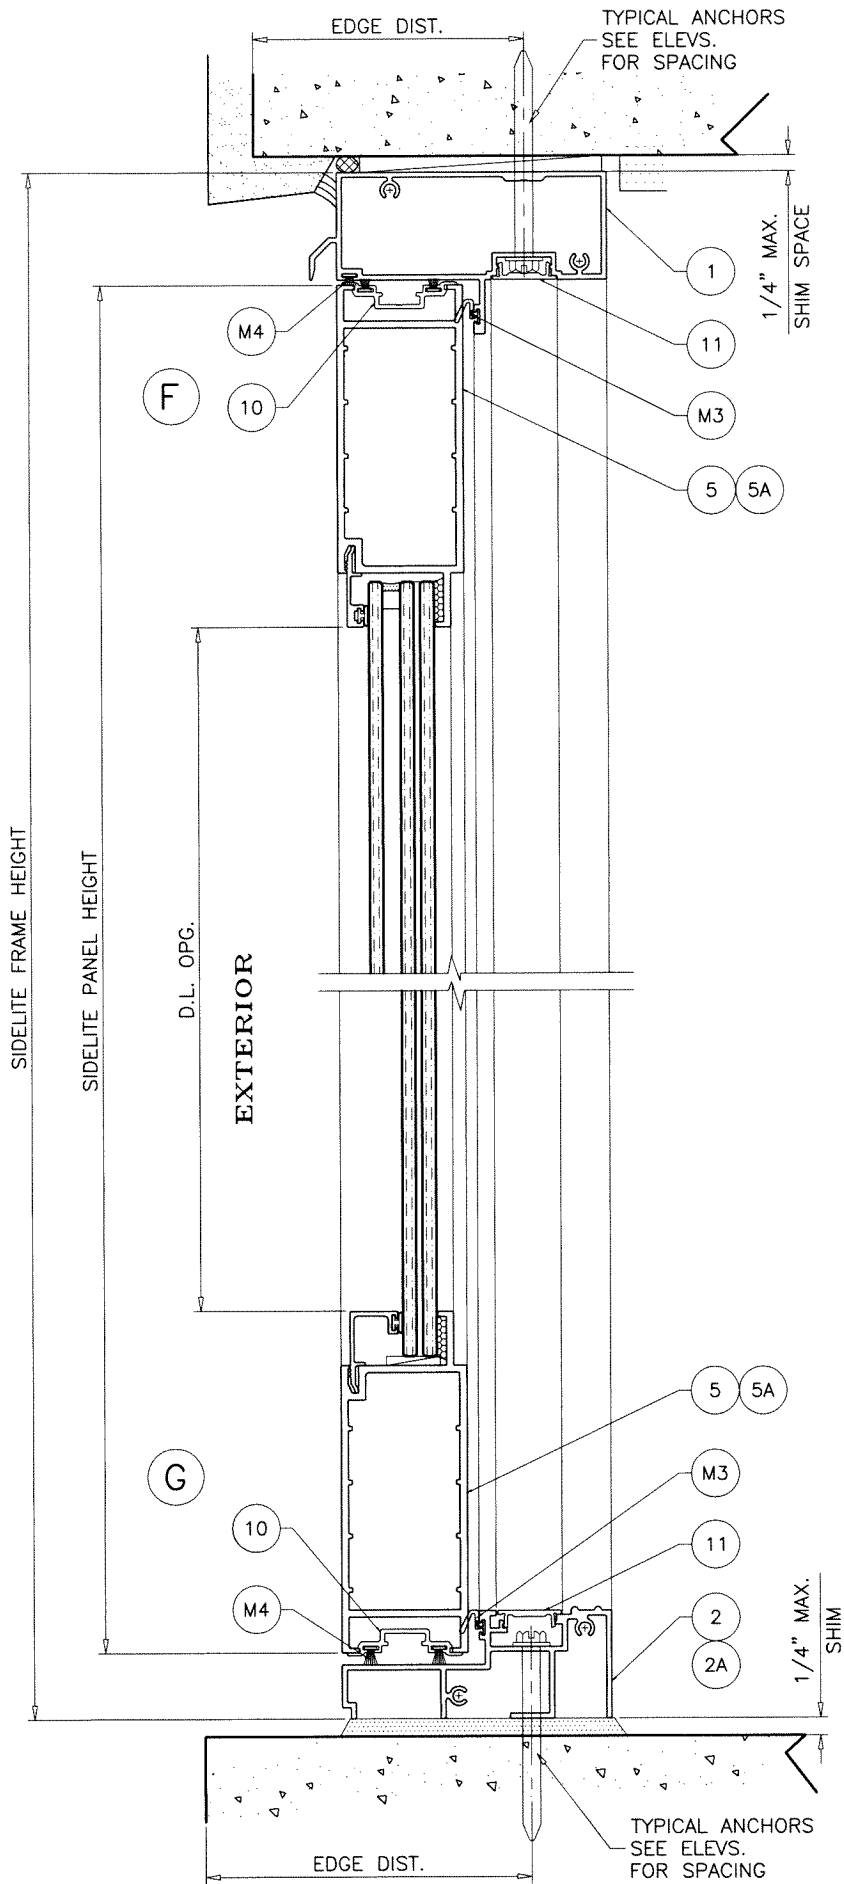


STD. THRESHOLD
APPROVED FOR WATER INFILTRATION RESISTANCE

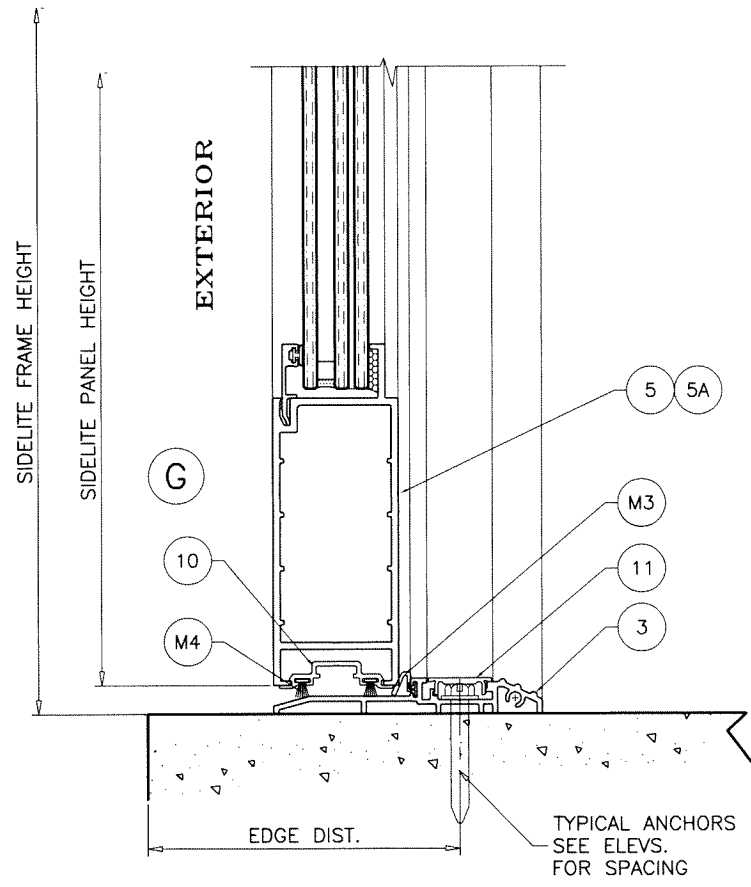

ADA THRESHOLD
NOT APPROVED FOR WATER INFILTRATION RESISTANCE

Sealed: 10/22/2024

SIDELITE DETAILS

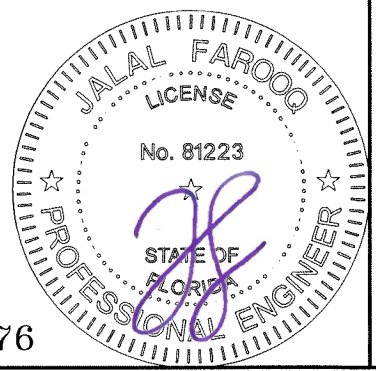

FL #46976

AL-FAROOQ CORPORATION
ENGINEERS & PRODUCT DEVELOPMENT
9360 SUNSET DRIVE, SUITE 220
MIAMI, FLORIDA 33173
TEL. (305) 264-8100 FAX. (305) 262-6978

a f c
COMP-ANL\21-14F-LI

SERIES 7600 ALUMINUM OUTSWING DOOR (L.M.I.)


Custom Window Systems Inc.
1900 S.W. 44th Avenue
Ocala, FL. 34474
Tel. (352) 368-6922

CWS

www.cws.cc


revisions:		no	date	by	description

date: 02-22-21	scale: 3/8" = 1"	dr. by: TARIQ	chk. by:	drawing no. 21-14F
				sheet 10 of 15

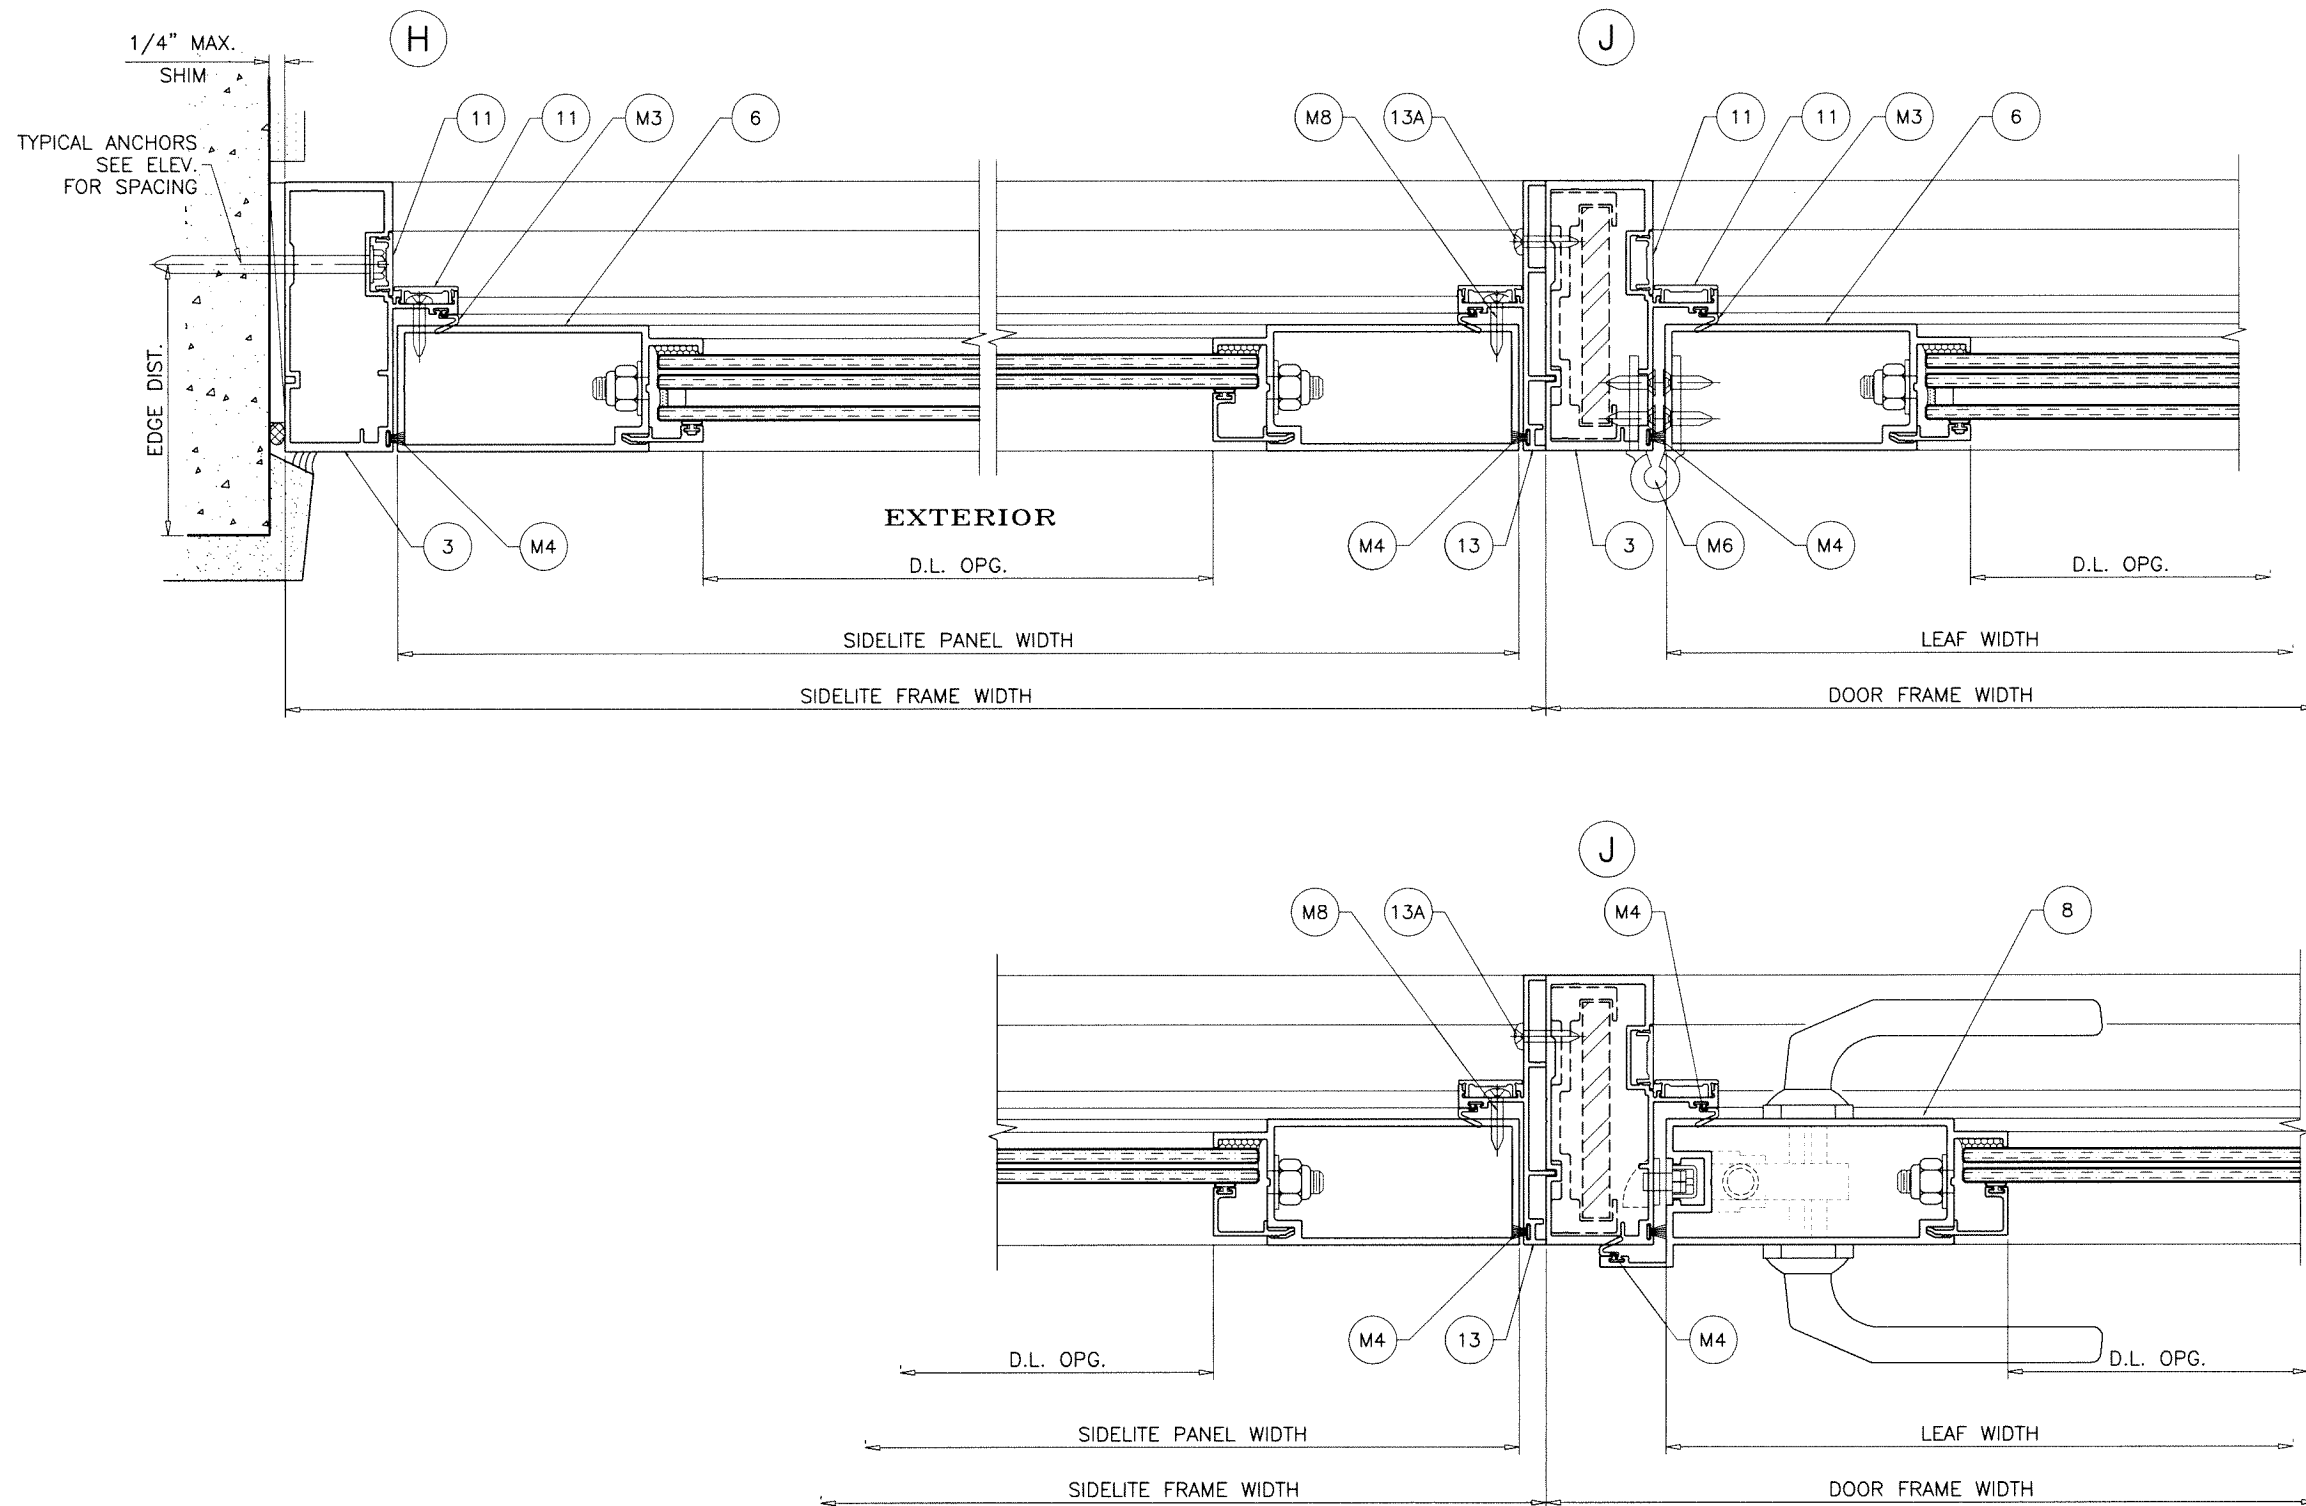

SIDELITE DETAILS

Sealed: 10/22/2024

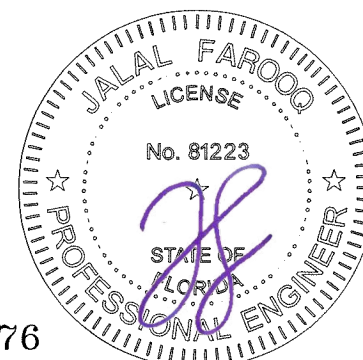

FL #46976

AL-FAROOQ CORPORATION
ENGINEERS & PRODUCT DEVELOPMENT
9360 SUNSET DRIVE, SUITE 220
MIAMI, FLORIDA 33173
TEL. (305) 264-8100 FAX. (305) 262-6978

af c
COMP-ANL\21-14F-LI

SERIES 7600 ALUMINUM OUTSWING DOOR (L.M.I.)

Custom Window Systems Inc.
1900 S.W. 44th Avenue
Ocala, FL 34474
Tel. (352) 368-6922

CWS www.cws.cc

21-14F

sheet 11 of 15

revisions:	
no	description

date: 02-22-21	scale: 3/8" = 1"	dr. by: TARIQ	chk. by:
----------------	------------------	---------------	----------

LOCKS:

OPTION #1:


MAX. LEAF HEIGHT = 118-1/16 IN.
MAX. LEAF WIDTH = 45-3/4 IN.
MAX. DESIGN LOAD = + 55.0
- 55.0 PSF

ACTIVE LEAF:

6 POINT LOCK ASSEMBLY BY 'YALE' OR 'RADISSON INDUSTRIES'
(4) LOCKING POINTS ENGAGING AT INACTIVE LEAF AT STRIKE PLATE
1/2" DIA. THROW BOLT (1) AT TOP ENGAGING FRAME HEAD
AND (1) AT BOTTOM ENGAGING FRAME SILL
THROW BOLTS ATTACHED TO LOCK BY 3/8" CONNECTING RODS
LOCK HANDLE LOCATED AT 42-1/2" FROM BOTTOM

INACTIVE LEAF:

CONCEALED FLUSH BOLTS
1/2" X 2" THROW BOLTS ENGAGING FRAME AT HEAD AND SILL
MANUALLY OPERATED LEVERS MOUNTED ON INSIDE FACE
OF LEAF STILE LOCATED AT 10-5/8" FROM TOP AND BOTTOM
LOCK FASTENED TO STILE WITH (2) #8-32 X 1/2" FH MS

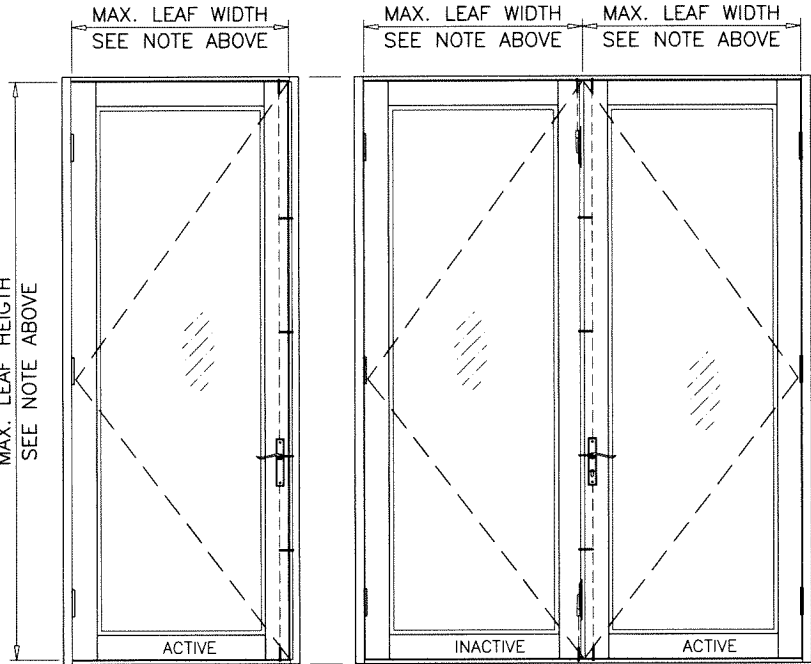

OPTION #2:

MAX. LEAF HEIGHT = 107-1/2 IN.
MAX. LEAF WIDTH = 45-3/4 IN.
MAX. DESIGN LOAD = + 55.0
- 55.0 PSF

MAX. LEAF HEIGHT = 94-1/16 IN.
MAX. LEAF WIDTH = 37-1/8 IN.
MAX. DESIGN LOAD = + 75.0
- 80.0 PSF


MAX. LEAF HEIGHT = 81-1/2 IN.
MAX. LEAF WIDTH = 45-3/4 IN.
MAX. DESIGN LOAD = + 67.0
- 72.0 PSF

ACTIVE LEAF:

5 POINT LOCK ASSEMBLY 'BY' 'YALE' OR 'RADISSON INDUSTRIES'
(3) LOCKING POINTS ENGAGING AT INACTIVE LEAF AT STRIKE PLATE
1/2" DIA. THROW BOLT (1) AT TOP ENGAGING FRAME HEAD
AND (1) AT BOTTOM ENGAGING FRAME SILL
THROW BOLTS ATTACHED TO LOCK BY 3/8" CONNECTING RODS
LOCK HANDLE LOCATED AT 42-1/2" FROM BOTTOM

INACTIVE LEAF:

CONCEALED FLUSH BOLTS
1/2" X 2" THROW BOLTS ENGAGING FRAME AT HEAD AND SILL
MANUALLY OPERATED LEVERS MOUNTED ON INSIDE FACE
OF LEAF STILE LOCATED AT 10-5/8" FROM TOP AND BOTTOM
LOCK FASTENED TO STILE WITH (2) #8-32 X 1/2" FH MS

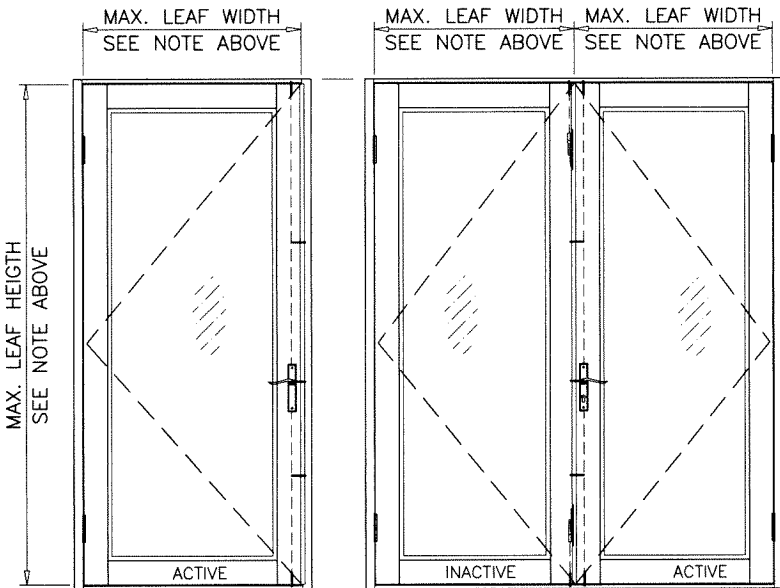

OPTION #3:

MAX. LEAF HEIGHT = 107-1/2 IN.
MAX. LEAF WIDTH = 45-3/4 IN.
MAX. DESIGN LOAD = + 55.0
- 55.0 PSF

MAX. LEAF HEIGHT = 93-1/2 IN.
MAX. LEAF WIDTH = 37-1/8 IN.
MAX. DESIGN LOAD = + 75.0
- 80.0 PSF

MAX. LEAF HEIGHT = 81-1/2 IN.
MAX. LEAF WIDTH = 45-3/4 IN.
MAX. DESIGN LOAD = + 67.0
- 72.0 PSF


ACTIVE LEAF:

3 POINT LOCK ASSEMBLY 'BY' 'YALE' OR 'RADISSON INDUSTRIES'
(1) LOCKING POINT ENGAGING AT INACTIVE LEAF AT STRIKE PLATE
1/2" DIA. THROW BOLT (1) AT TOP ENGAGING FRAME HEAD
AND (1) AT BOTTOM ENGAGING FRAME SILL
THROW BOLTS ATTACHED TO LOCK BY 3/8" CONNECTING RODS
LOCK HANDLE LOCATED AT 42-1/2" FROM BOTTOM

INACTIVE LEAF:

CONCEALED FLUSH BOLTS
1/2" X 2" THROW BOLTS ENGAGING FRAME AT HEAD AND SILL
MANUALLY OPERATED LEVERS MOUNTED ON INSIDE FACE
OF LEAF STILE LOCATED AT 10-5/8" FROM TOP AND BOTTOM
LOCK FASTENED TO STILE WITH (2) #8-32 X 1/2" FH MS

2 POINT EURO LOCK

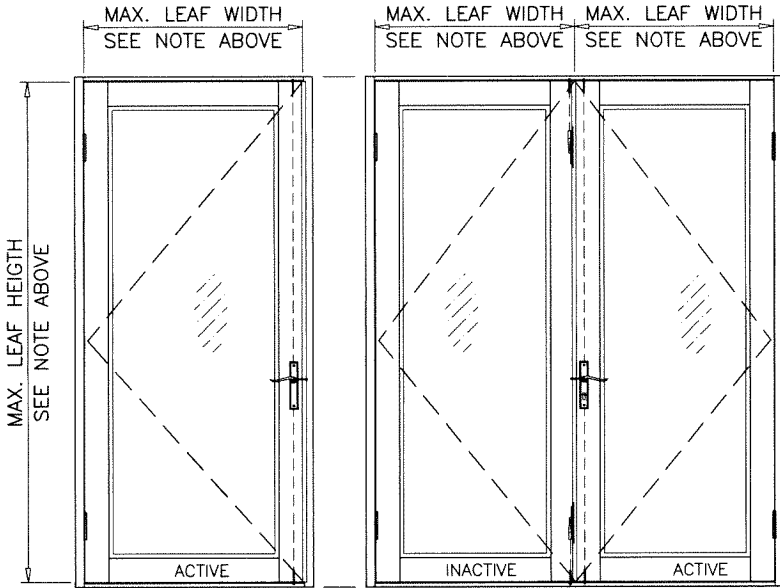

Sealed: 10/22/2024



FL #46976

af c
AL-FAROOQ CORPORATION
ENGINEERS & PRODUCT DEVELOPMENT
9360 SUNSET DRIVE, SUITE 220 (C.A.N. 3538)
MIAMI, FLORIDA 33173 FAX: (305) 262-6978
TEL: (305) 264-8100

SERIES 7600 ALUMINUM OUTSWING DOOR (L.M.I.)
Custom Window Systems Inc.
1900 S.W. 44th Avenue
Ocala, FL. 34474
Tel. (352) 368-6922
www.cws.cc

revisions:		no date by description	
date:	02-22-21	scale:	3/8" = 1"
dr. by:	TARIQ	chk. by:	
drawing no.		21-14F	
sheet 12 of 15			

COMP-ANL\21-14F-LI

OPTION #4:

MAX. LEAF HEIGHT = 107-1/2 IN.
MAX. LEAF WIDTH = 45-3/4 IN.
MAX. DESIGN LOAD = + 55.0
- 55.0 PSF

MAX. LEAF HEIGHT = 93-1/2 IN.
MAX. LEAF WIDTH = 35-3/4 IN.
MAX. DESIGN LOAD = + 75.0
- 80.0 PSF

MAX. LEAF HEIGHT = 81-1/2 IN.
MAX. LEAF WIDTH = 45-3/4 IN.
MAX. DESIGN LOAD = + 67.0
- 72.0 PSF


ACTIVE LEAF:

CONVENTIONAL DOOR LOCKSET WITH HANDLE BY 'SCHLAGE/KWIKSET'
LOCATED AT 39-1/4" FROM BOTTOM
KEY OPERATED ON EXTERIOR AND THUMB TURN ON
INTERIOR THROW BOLT LOCATED AT 37-3/4" FROM BOTTOM

CONCEALED FLUSH BOLTS
1/2" X 2" THROW BOLTS ENGAGING FRAME AT HEAD AND SILL
MANUALLY OPERATED LEVERS MOUNTED ON STILE FACE
LOCATED AT 10-5/8" FROM TOP AND BOTTOM
LOCK FASTENED TO STILE WITH (2) #8-32 X 1/2" FH MS

INACTIVE LEAF:


CONCEALED FLUSH BOLTS
1/2" X 2" THROW BOLTS ENGAGING FRAME AT HEAD AND SILL
MANUALLY OPERATED LEVERS MOUNTED ON INSIDE FACE
OF LEAF STILE LOCATED AT 10-5/8" FROM TOP AND BOTTOM
LOCK FASTENED TO STILE WITH (2) #8-32 X 1/2" FH MS

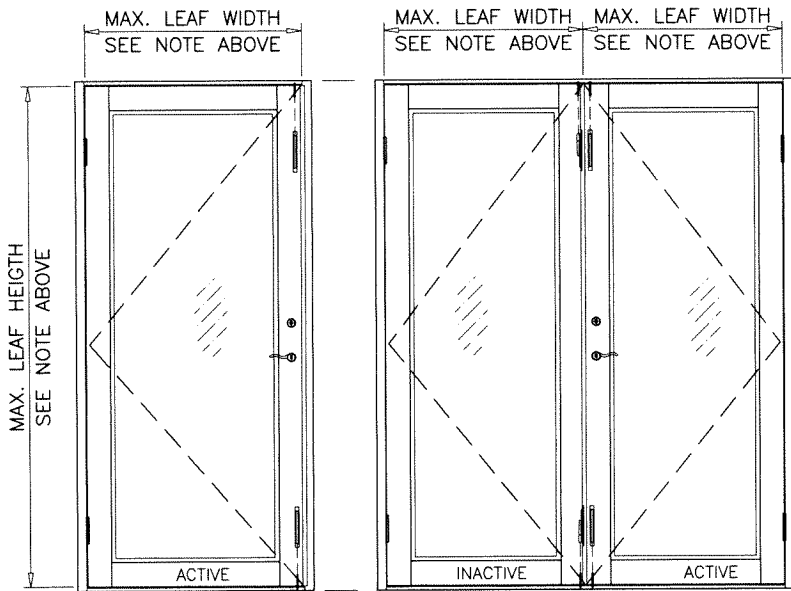

HINGES:

.122" THK. EXTRUDED ALUM HINGE BY 'LAPORTE'
2 HINGES PER LEAF FOR DOORS UPTO 96" HEIGHTS
3 HINGES PER LEAF FOR DOORS ABOVE 96" HEIGHTS
BOTTOM HINGE AT 7-1/2" FROM BOTTOM
TOP HINGE AT 8-1/2" FROM TOP
CENTER HINGE AT MIDSPAN (FOR DOORS ABOVE 96" HEIGHT)
HINGES FASTENED WITH #10 X 3/4" FH SMS
(4) SCREWS AT HINGE STILE
(4) SCREWS AT FRAME JAMB

Sealed: 10/22/2024



















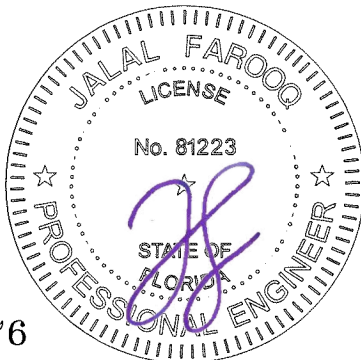


FL #46976


af c
AL-FAROOQ CORPORATION
ENGINEERS & PRODUCT DEVELOPMENT
9360 SUNSET DRIVE, SUITE 220 (C.A.N. 3538)
MIAMI, FLORIDA 33173
TEL. (305) 264-8100 FAX. (305) 262-6978
COMP-ANL\21-14F-LI

SERIES 7600 ALUMINUM OUTSWING DOOR (L.M.I.)
Custom Window Systems Inc.
1900 S.W. 44th Avenue
Ocala, FL. 34474
Tel. (352) 368-6922
www.cws.cc
CWS

revisions:		no date by description	
date:	02-22-21	scale:	3/8" = 1"
dr. by:	TARIQ	chk. by:	
drawing no.		21-14F	
sheet 12.1 of 15			

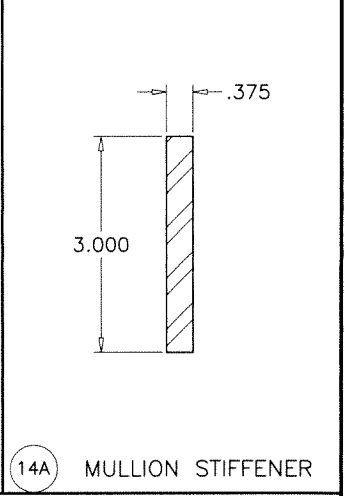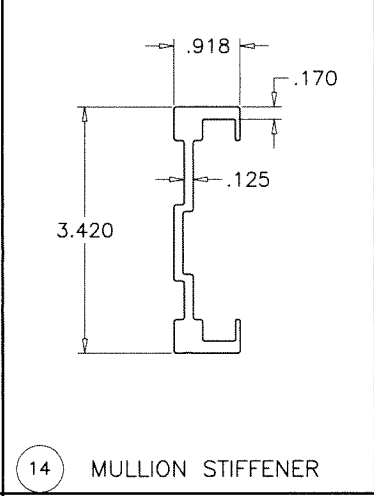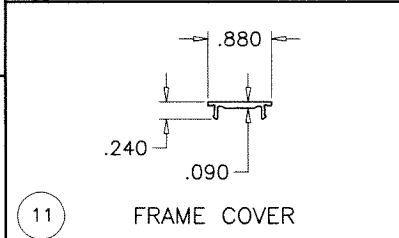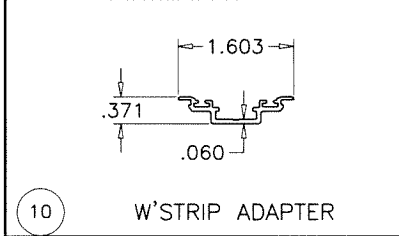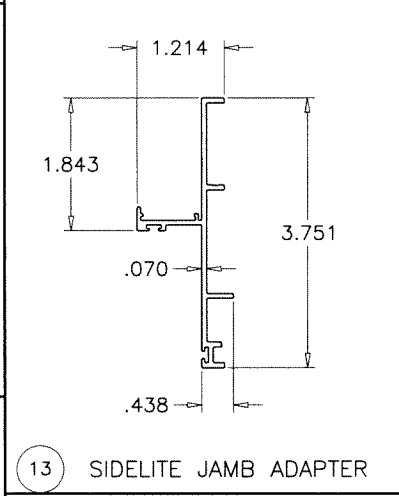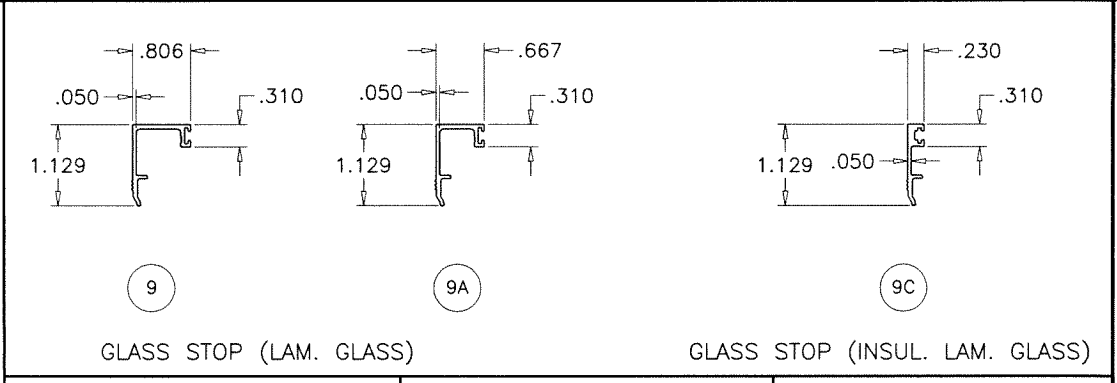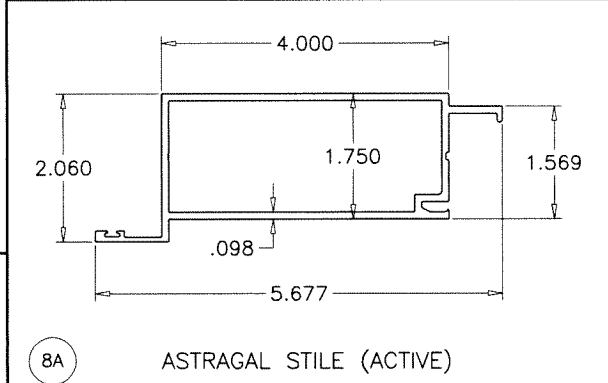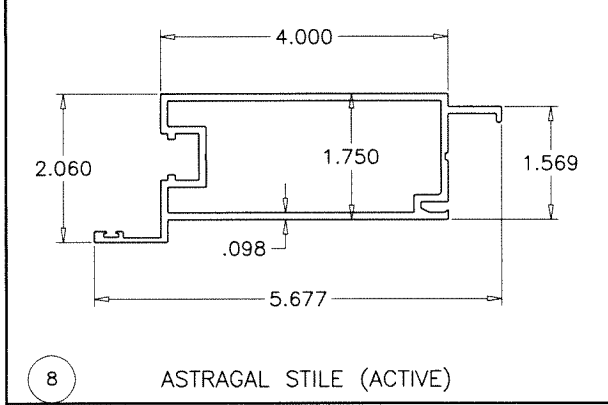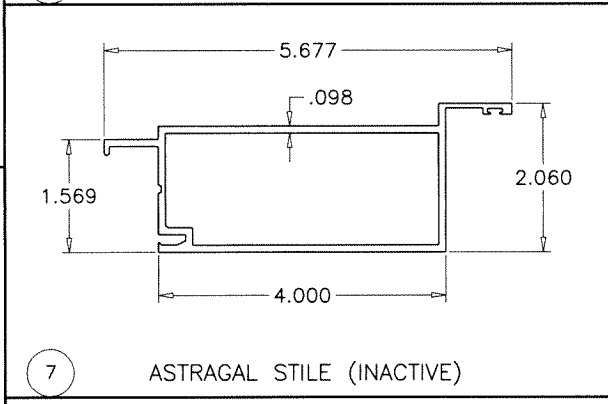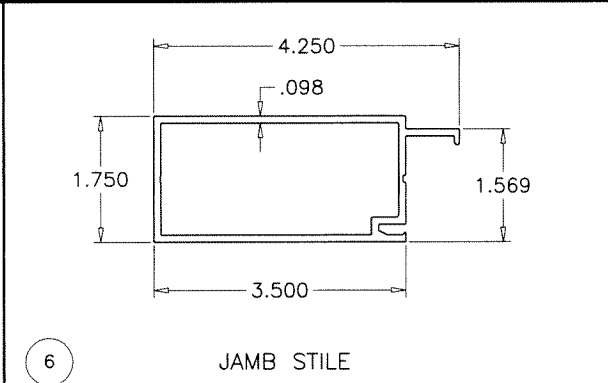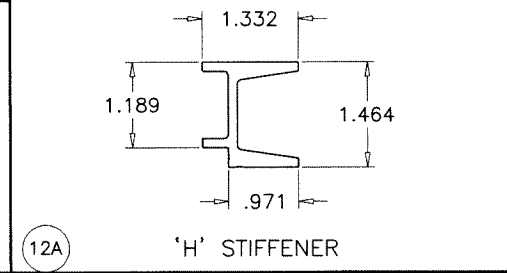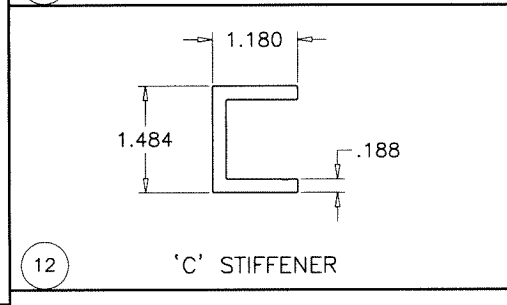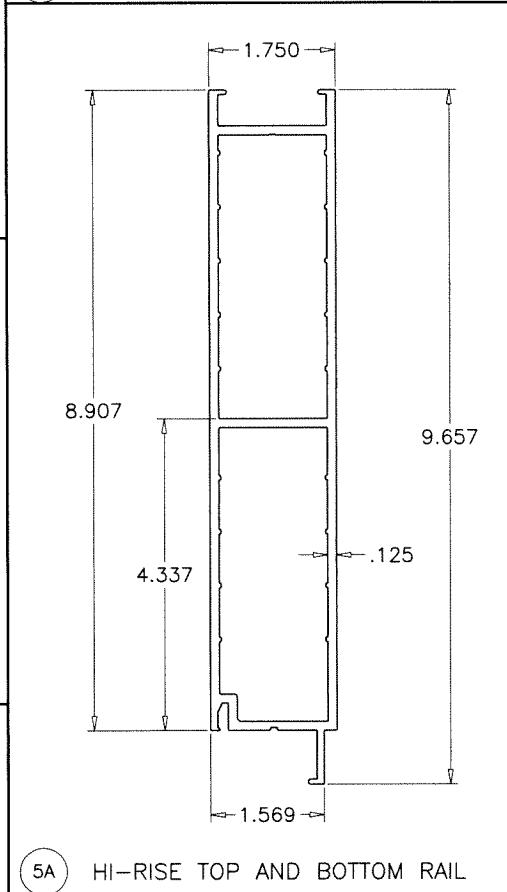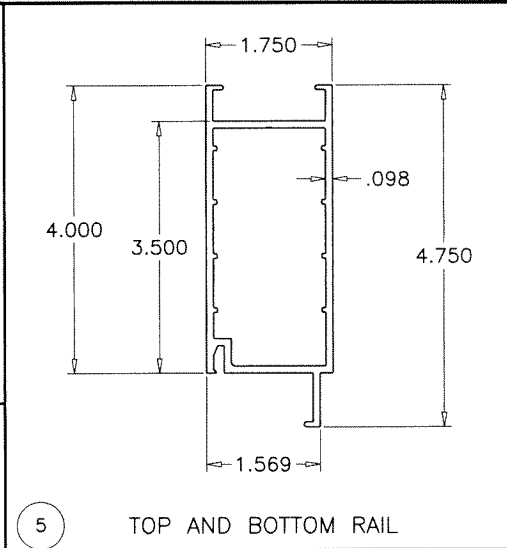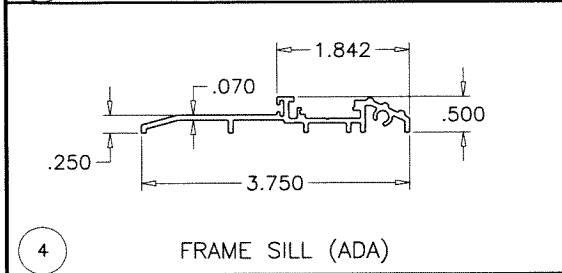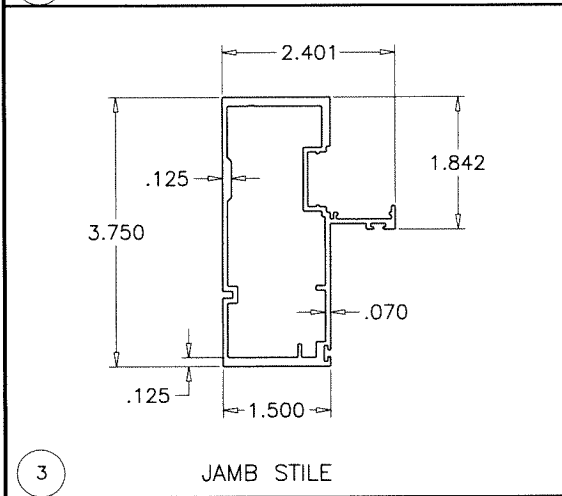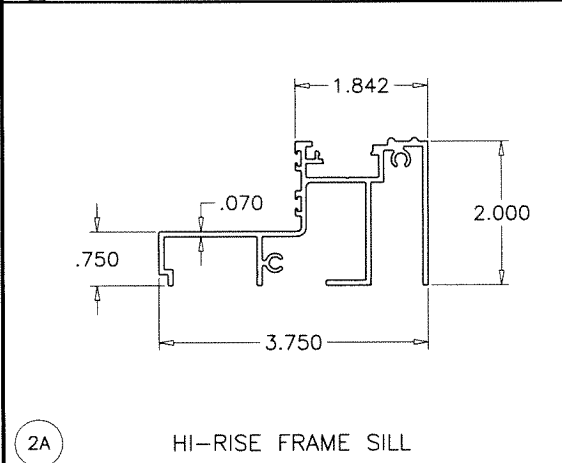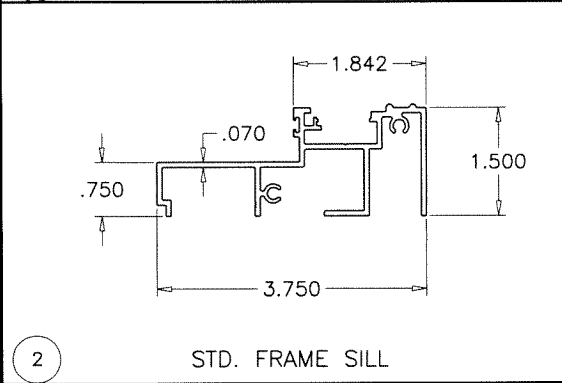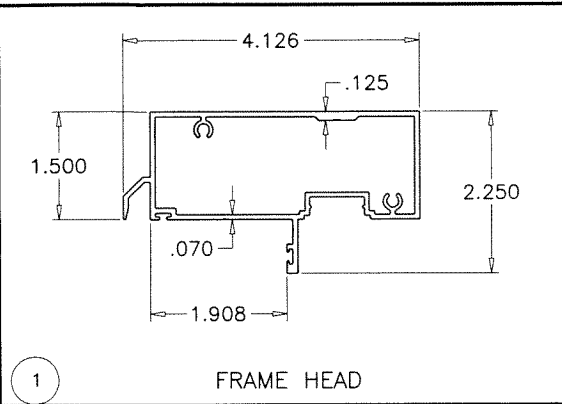

Sealed: 10/22/2024

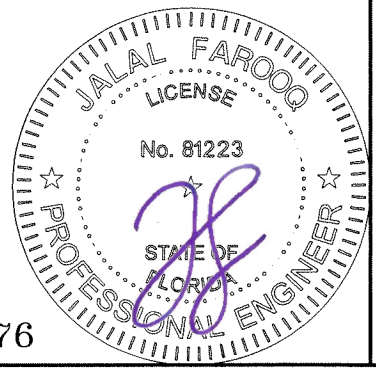

FL #46976

AL-FAROOQ CORPORATION
ENGINEERS & PRODUCT DEVELOPMENT
9360 SUNSET DRIVE, SUITE 220
MIAMI, FLORIDA 33173
TEL. (305) 264-8100 FAX. (305) 262-6978
(C.A.N. 3538)

COMP-ANL\21-14F-LI

SERIES 7600 ALUMINUM OUTSWING DOOR (L.M.I.)

Custom Window Systems Inc.
1900 S.W. 44th Avenue
Ocala, FL 34474
Tel. (352) 368-6922
www.cws.cc

revisions:	
no	date by description


date: 02-22-21	scale: 3/8" = 1"	dr. by: TARIQ	chk. by:	drawing no. 21-14F
				sheet 13 of 15

ITEM #	PART #	REQD.	DESCRIPTION	MATERIAL	MANF./SUPPLIER/REMARKS
1	LAW-2401	1	FRAME HEAD	6063-T6	-
2	LAW-2402	1	STD. FRAME SILL (1-1/2" HT.)	6063-T6	-
2A	LAW-2403	1	HI-RISE FRAME SILL (2" HT.)	6063-T6	-
3	LAW-2421	1	FRAME SILL (ADA)	6063-T6	-
4	LAW-2404	2	FRAME JAMB	6063-T6	-
5	LAW-2406	2/ LEAF	TOP AND BOTTOM RAIL	6063-T6	-
5A	LAW-2407	2/ LEAF	HI-RISE TOP AND BOTTOM RAIL	6063-T6	-
6	LAW-2408	1/ LEAF	JAMB STILE	6063-T6	-
7	LAW-2410	1	ASTRAGAL STILE (INACTIVE)	6063-T6	-
8	LAW-2411	1	ASTRAGAL STILE (ACTIVE) (EURO LOCK)	6063-T6	-
8A	LAW-2409	1	ASTRAGAL STILE (ACTIVE)	6063-T6	-
9	LAW-2412	4/ LEAF	GLASS STOP (5/16" LAM. GLASS)	6063-T6	-
9A	LAW-2413	4/ LEAF	GLASS STOP (7/16" LAM. GLASS)	6063-T6	-
9C	LAW-2415	4/ LEAF	GLASS STOP (7/8" INSUL. LAM. GLASS)	6063-T6	-
10	LAW-2425	2/ LEAF	W'STRIP ADAPTER	6063-T5	-
11	LAW-2418	AS REQD.	FRAME COVER	6063-T6	-
12	LAW-2424	AS REQD.	'C' STIFFENER, 29" LONG	6063-T6	-
12A	LAW-2425	AS REQD.	'H' STIFFENER, 60" LONG	6063-T6	-
13	LAW-2405	AS REQD.	SIDELITE JAMB ADAPTER	6063-T6	-
13A	#10 X 1"	AS REQD.	ADAPTER FASTENERS, AT 6" FROM ENDS & 12" O.C.	ST/ST	PH SMS
14	LAW-2423	AS REQD.	MULLION STIFFENER	6063-T6	-
14A	-	AS REQD.	MULLION STIFFENER	STEEL	A36, Fu MIN. = 56 KSI
M1	-	AS REQD.	GLAZING GASKET	SILICONE	DUROMETER 65±5 SHORE A
M2	-	2/ LITE	SETTING BLOCKS AT 1/4 POINTS	SILICONE	DUROMETER 80±5 SHORE A
M3	-	AS REQD.	Q-LON FLAP W'STRIPPING	-	-
M4	150	AS REQD.	FRAME PERIMETER PILE W'STRIPPING	POLYPROPYLENE	-
M5	210	AS REQD.	PILE W'STRIPPING	WOOL	-
M6	-	AS REQD.	HINGE ASSEMBLY	-	HAGER
M6A	#10 X 3/4"	8/ HINGE	HINGE FASTENERS	ST/ST	FH SMS
M7	#12 X 3/4"	AS REQD.	FRAME ASSEMBLY FASTENERS	ST/ST	PH SMS
M8	#10 X 1"	AS REQD.	FIX. PANEL FASTENERS, AT 6" FROM ENDS & 12" O.C.	ST/ST	PH SMS
M9	-	2/ LEAF	3/8" DIA. THREADED ROD	STEEL	-
-	-	-	-	-	-

SEALANTS:

ALL FRAME AND LEAF JOINTS AND SEAMS SEALED
WITH SM 5504 SEALANT.

Sealed: 10/22/2024

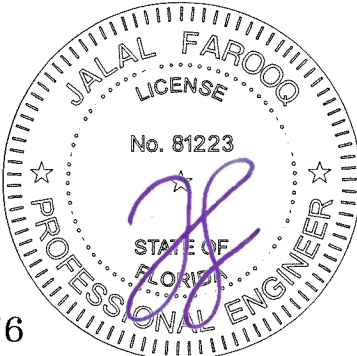

FL #46976



AL-FAROOQ CORPORATION
ENGINEERS & PRODUCT DEVELOPMENT
9360 SUNSET DRIVE, SUITE 220
MIAMI, FLORIDA 33173 (C.A.N. 3538)
TEL. (305) 264-8100 FAX. (305) 262-6978

SERIES 7600 ALUMINUM OUTSWING DOOR (L.M.I.)

Custom Window Systems Inc.
1900 S.W. 44th Avenue
Ocala, FL. 34474
Tel. (352) 368-6922
www.cws.cc







revisions:


no	date	by	description

date: 02-22-21
scale: 3/8" = 1"
dr. by: TARIQ
chk. by:

drawing no.
21-14F
sheet 14 of 15

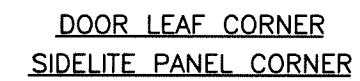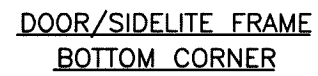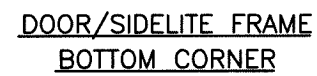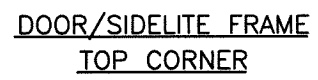

Sealed: 10/22/2024

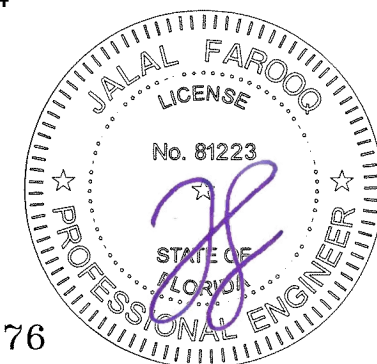

FL #46976

AL-FAROOQ CORPORATION
ENGINEERS & PRODUCT DEVELOPMENT
9360 SUNSET DRIVE, SUITE 220
MIAMI, FLORIDA 33173 (C.A.N. 3538)
TEL. (305) 264-8100 FAX. (305) 262-6978

SERIES 7600 ALUMINUM OUTSWING DOOR (L.M.I.)

 **Custom Window Systems Inc.**
1900 S.W. 44th Avenue
Ocala, FL 34474
Tel. (352) 368-6922
www.cws.cc

date: 02-22-21		revisions:	
scale: 3/8" = 1"		no	by
dr. by: TARIQ			
chk. by:			
drawing no. 21-14F			
sheet 15 of 15			