



Product Approval
USER: Public User

3

[Product Approval Menu](#) > **Application Detail**

FL #	FL46529								
Application Type	New								
Code Version	2023								
Application Status	Approved								
*Approved by DBPR. Approvals by DBPR shall be reviewed and ratified by the POC and/or the Commission if necessary.									
Comments									
Archived	☐								
Product Manufacturer	Custom Window Systems Inc.								
Address/Phone/Email	1900 SW 44th Avenue Ocala, FL 34474 (352) 368-6922 certifications@cws.cc								
Authorized Signature	Mary Rukashaza-Mukome certifications@cws.cc								
Technical Representative	Mary Rukashaza-Mukome								
Address/Phone/Email	1900 SW 44th Avenue Ocala, FL 34474 (641) 621-3317 rukashazamc@pella.com								
Quality Assurance Representative	Steven Bailey								
Address/Phone/Email	8501 NW 90th St. Medley, FL 33166 (305) 696-8660 sbailey@cws.cc								
Category	Exterior Doors								
Subcategory	Sliding Exterior Door Assemblies								
Compliance Method	Certification Mark or Listing								
Certification Agency	Miami-Dade BCCO - CER								
Validated By	Miami-Dade BCCO - VAL								
Referenced Standard and Year (of Standard)	<table><tr><th>Standard</th><th>Year</th></tr><tr><td>TAS 201</td><td>1994</td></tr><tr><td>TAS 202</td><td>1994</td></tr><tr><td>TAS 203</td><td>1994</td></tr></table>	Standard	Year	TAS 201	1994	TAS 202	1994	TAS 203	1994
Standard	Year								
TAS 201	1994								
TAS 202	1994								
TAS 203	1994								
Equivalence of Product Standards Certified By									

Product Approval Method

Method 1 Option A

Date Submitted

02/14/2024

Date Validated

02/27/2024

Date Pending FBC Approval

Date Approved

02/29/2024

Summary of Products		
FL #	Model, Number or Name	Description
46529.1	380 Aluminum Sliding Glass Door - Heavy Reinforcement	380 Aluminum Sliding Glass Door - Heavy Reinforcement XX, OX, XO, XXX, OXO, OXXO, XXp, pXX, pXXX, XXXp, pXXXX, pXXXXp, OXXXp, pXXOX Configurations
Limits of Use Approved for use in HVHZ: Yes Approved for use outside HVHZ: Yes Impact Resistant: No Design Pressure: +77.8/-110.1 Other: Please refer to the NOA for all other limitations.		Certification Agency Certificate FL46529_R0_C_CAC_240116_20 - 380 Alum SGD Reinf.pdf Quality Assurance Contract Expiration Date 08/26/2028 Installation Instructions FL46529_R0_II_240116_20 - 380 Alum SGD Reinf.pdf Verified By: Thomas J. Sotos, P.E. 55225 Created by Independent Third Party: No Evaluation Reports Created by Independent Third Party:
46529.2	380 Aluminum Sliding Glass Door - Light Reinforcement	380 Aluminum Sliding Glass Door - Light Reinforcement XX, OX, XO, XXX, OXO, OXXO, XXp, pXX, pXXX, XXXp, pXXXX, pXXXXp, OXXXp, pXXOX Configurations
Limits of Use Approved for use in HVHZ: Yes Approved for use outside HVHZ: Yes Impact Resistant: No Design Pressure: +77.8/-99 Other: Please refer to the NOA for all other limitations.		Certification Agency Certificate FL46529_R0_C_CAC_240116_19 - 380 Alum SGD Standard.pdf Quality Assurance Contract Expiration Date 08/26/2028 Installation Instructions FL46529_R0_II_240116_19 - 380 Alum SGD Standard.pdf Verified By: Thomas J. Sotos, P.E. 55225 Created by Independent Third Party: No Evaluation Reports Created by Independent Third Party:
46529.3	380 Aluminum Sliding Glass Door - Without Reinforcement	380 Aluminum Sliding Glass Door - Without Reinforcement XX, OX, XO, XXX, OXO, OXXO, XXp, pXX, pXXX, XXXp, pXXXX, pXXXXp, OXXXp, pXXOX Configurations
Limits of Use Approved for use in HVHZ: Yes Approved for use outside HVHZ: Yes Impact Resistant: No Design Pressure: +64/-89 Other: Please refer to the NOA for all other limitations.		Certification Agency Certificate FL46529_R0_C_CAC_240116_21 - 380 Alum SGD no Steel.pdf Quality Assurance Contract Expiration Date 08/26/2028 Installation Instructions FL46529_R0_II_240116_21 - 380 Alum SGD no Steel.pdf Verified By: Thomas J. Sotos, P.E. 55225 Created by Independent Third Party: No Evaluation Reports Created by Independent Third Party:
46529.4	7900 Impact Aluminum Sliding Glass Door	7900 Impact Aluminum Sliding Glass Door - XO, OX, XX, OXO, XXX, OXXO, XXXX Configurations including L, R, & Double Pockets
Limits of Use Approved for use in HVHZ: Yes Approved for use outside HVHZ: Yes Impact Resistant: Yes Design Pressure: +76/-85 Other: Please refer to the NOA for all other limitations.		Certification Agency Certificate FL46529_R0_C_CAC_240116_13 - 7900 Alum SGD.pdf Quality Assurance Contract Expiration Date 02/13/2028 Installation Instructions FL46529_R0_II_240116_13 - 7900 Alum SGD.pdf Verified By: Thomas J. Sotos, P.E. 55225 Created by Independent Third Party: No Evaluation Reports Created by Independent Third Party:

Back

Next

Contact Us :: 2601 Blair Stone Road, Tallahassee FL 32399 Phone: 850-487-1824

The State of Florida is an AA/EEO employer. [Copyright 2007-2013 State of Florida.](#) :: [Privacy Statement](#) :: [Accessibility Statement](#) :: [Refund Statement](#)

Under Florida law, email addresses are public records. If you do not want your e-mail address released in response to a public-records request, do not send electronic mail to this entity. Instead, contact the office by phone or by traditional mail. If you have any questions, please contact 850.487.1395. *Pursuant to Section 455.275(1), Florida Statutes, effective October 1, 2012, licensees licensed under Chapter 455, F.S. must provide the Department with an email address if they have one. The emails provided may be used for official communication with the licensee. However email addresses are public record. If you do not wish to supply a personal address, please provide the Department with an email address which can be made available to the public. To determine if you are a licensee under Chapter 455, F.S., please click [here](#).

Product Approval Accepts:





DEPARTMENT OF REGULATORY AND ECONOMIC RESOURCES (RER)
BOARD AND CODE ADMINISTRATION DIVISION
NOTICE OF ACCEPTANCE (NOA)

MIAMI-DADE COUNTY
PRODUCT CONTROL SECTION
11805 SW 26 Street, Room 208
Miami, Florida 33175-2474
T (786) 315-2590 F (786) 315-2599
www.miamidade.gov/economy

Custom Window System, Inc.
1900 SW 44th Ave.,
Ocala, FL 34474

SCOPE:

This NOA is being issued under the applicable rules and regulations governing the use of construction materials. The documentation submitted has been reviewed and accepted by Miami-Dade County RER Product Control Section to be used in Miami Dade County and other areas where allowed by the Authority Having Jurisdiction (AHJ).

This NOA shall not be valid after the expiration date stated below. The Miami-Dade County Product Control Section (In Miami Dade County) and/or the AHJ (in areas other than Miami Dade County) reserve the right to have this product or material tested for quality assurance purposes. If this product or material fails to perform in the accepted manner, the manufacturer will incur the expense of such testing and the AHJ may immediately revoke, modify, or suspend the use of such product or material within their jurisdiction. RER reserves the right to revoke this acceptance, if it is determined by Miami-Dade County Product Control Section that this product or material fails to meet the requirements of the applicable building code.

This product is approved as described herein and has been designed to comply with the Florida Building Code, including the High Velocity Hurricane Zone.

DESCRIPTION: Series "7900" Aluminum Sliding Glass Door (Steel Reinforced) – L.M.I.

APPROVAL DOCUMENT: Drawing No. **CWS-1223**, titled "7900 Aluminum Sliding Door-Impact", sheets 1 through 14 of 14, dated DEC 18, 2023, prepared by manufacturer, signed and sealed by Thomas J. Sotos, P.E., bearing the Miami-Dade County Product Control Revision stamp with the Notice of Acceptance number and expiration date by the Miami-Dade County Product Control Section.

MISSILE IMPACT RATING: Large and Small Missile Impact Resistant

Limitations:

1. See Design Pressure (DP) VS door size, glass type, reinforcements, sill type and configuration in sheet **2**, sheet **5**, and sheet **8**.
2. See pocket installation detail in sheet **11** and notes #15 and #16 in sheet **1**.
3. Applicable Egress requirements to be reviewed by AHJ.

LABELING: Each unit shall bear a permanent label with the manufacturer's name or logo, city, state and series and following statement: "Miami-Dade County Product Control Approved", unless otherwise noted herein.

RENEWAL of this NOA shall be considered after a renewal application has been filed and there has been no change in the applicable building code negatively affecting the performance of this product.

TERMINATION of this NOA will occur after the expiration date or if there has been a revision or change in the materials, use, and/or manufacture of the product or process. Misuse of this NOA as an endorsement of any product, for sales, advertising or any other purposes shall automatically terminate this NOA. Failure to comply with any section of this NOA shall be cause for termination and removal of NOA.

ADVERTISEMENT: The NOA number preceded by the words Miami-Dade County, Florida, and followed by the expiration date may be displayed in advertising literature. If any portion of the NOA is displayed, then it shall be done in its entirety.

INSPECTION: A copy of this entire NOA shall be provided to the user by the manufacturer or its distributors and shall be available for inspection at the job site at the request of the Building Official.

The submitted documentation was reviewed by Ishaq I. Chanda, P.E.

Ishaq I. Chanda



NOA No. 24-0116.13
Expiration Date: February 13, 2028
Approval Date: February 01, 2024
Page 1

NOTICE OF ACCEPTANCE: EVIDENCE SUBMITTED

1. EVIDENCE SUBMITTED UNDER PREVIOUS NOA's

A. DRAWINGS

1. Manufacturer's die drawings and sections.
(Submitted under NOA No. 12-1204.12)
2. Drawing No. **L9200-1201**, titled "Series SGD-9200 Aluminum Sliding Glass Door (L.M.I.)", sheets 1 through 14 of 14, dated 09/25/12, with revision **D** dated 12/03/20, prepared by manufacturer, signed and sealed by Thomas J. Sotos, P.E.
(Submitted under NOA No. 23-0119.03)

B. TESTS

1. Test reports on: 1) Uniform Static Air Pressure Test, Loading per FBC TAS 202-94 along with marked-up drawings and installation diagram of an aluminum sliding glass door, prepared by Hurricane Engineering & Testing, Inc., Test Reports No. **HETI-11-3269** dated 05/16/11, **HETI-11-3292** dated 10/20/11, **HETI-11-3274** dated 10/20/11, **HETI-11-3329** dated 01/16/12, **HETI-12-4040** dated 10/12/12, **HETI-12-4051** dated 06/13/12, **HETI-12-4053** and **HETI-12-4064**, dated 09/24/12, all signed and sealed by Rafael E. Droz-Seda, P.E.
(Submitted under NOA No. 12-1204.12)
2. Test reports on: 1) Large Missile Impact Test per FBC, TAS 201-94
2) Cyclic Wind Pressure Loading per FBC, TAS 203-94
along with marked-up drawings and installation diagram of an aluminum sliding glass door, prepared by Hurricane Engineering & Testing, Inc., Test Reports No. **HETI-11-3270** dated 05/16/11, **HETI-11-3275** dated 10/20/11, **HETI-11-3307** dated 10/03/11, **HETI-11-3314** dated 10/20/11, **HETI-11-3330** dated 01/16/12, **HETI-12-4052** dated 07/10/12, **HETI-12-4054** and **HETI-12-4065**, dated 09/24/12, all signed and sealed by Rafael E. Droz-Seda, P.E.
(Submitted under NOA No. 12-1204.12)
3. Test reports on: 1) Uniform Static Air Pressure Test, Loading per FBC TAS 202-94
2) Large Missile Impact Test per FBC, TAS 201-94
3) Cyclic Wind Pressure Loading per FBC, TAS 203-94
along with marked-up drawings and installation diagram of an aluminum sliding glass door, prepared by Hurricane Engineering & Testing, Inc., Test Report No. **HETI-12-4041** dated 10/12/12, signed and sealed by Rafael E. Droz-Seda, P.E.
(Submitted under NOA No. 12-1204.12)

Ishaq I. Chanda

Ishaq I. Chanda, P.E.
Product Control Unit Supervisor
NOA No. 24-0116.13
Expiration Date: February 13, 2028
Approval Date: February 01, 2024

NOTICE OF ACCEPTANCE: EVIDENCE SUBMITTED

1. EVIDENCE SUBMITTED UNDER PREVIOUS NOA's (CONTINUED)
B. TESTS (CONTINUED)

4. Test reports on: 1) Air Infiltration Test per FBC, TAS 202-94
2) Uniform Static Air Pressure Test, Loading per FBC TAS 202-94
3) Water Resistance Test per FBC, TAS 202-94
along with marked-up drawings and installation diagram of an aluminum sliding glass door, prepared by Hurricane Engineering & Testing, Inc., Test Reports No. **HETI-11-3291** dated 07/15/11 and **HETI-11-3292** dated 10/20/11, both signed and sealed by Rafael E. Droz-Seda, P.E.
(Submitted under NOA No. 12-1204.12)
5. Test reports on: 1) Air Infiltration Test, per FBC, TAS 202-94
2) Uniform Static Air Pressure Test, Loading per FBC, TAS 202-94
3) Water Resistance Test, per FBC, TAS 202-94
4) Large Missile Impact Test per FBC, TAS 201-94
5) Cyclic Wind Pressure Loading per FBC, TAS 203-94
6) Forced Entry Test, Type "C" sliding door, Grade 10, per FBC 2411.3.2.1, and TAS 202-94
along with marked-up drawings and installation diagram of an aluminum sliding glass door, prepared by Hurricane Engineering & Testing, Inc., Test Report No. **HETI-11-3313**, dated 10/20/11, signed and sealed by Rafael E. Droz-Seda, P.E.
(Submitted under NOA No. 12-1204.12)
6. Test reports on: 1) Air Infiltration Test, per FBC, TAS 202-94
2) Uniform Static Air Pressure Test, Loading per FBC, TAS 202-94
3) Water Resistance Test, per FBC, TAS 202-94
4) Large Missile Impact Test per FBC, TAS 201-94
5) Cyclic Wind Pressure Loading per FBC, TAS 203-94
6) Forced Entry Test, Type "C" sliding door, Grade 10, per FBC 2411.3.2.1, and TAS 202-94
along with marked-up drawings and installation diagram of an aluminum sliding glass door, prepared by Fenestration Testing Laboratory, Inc., Test Reports No. **FTL-3078** dated 01/10/02, signed and sealed by Luis Figueredo, P.E.; **FTL-3525** and **FTL-3572**, dated 09/09/02, both signed and sealed by Joseph C. Chan, P.E.; **FTL-3424** dated 04/18/02, **FTL-3425** dated 04/29/02, **FTL-3426** dated 04/26/02, **FTL-3492** dated 06/20/02, **FTL-3493**, dated 06/24/02 and **FTL-3516** dated 07/12/02, all signed and sealed by James G. Worth, P.E.
(Submitted under NOA No. 02-1126.04)



Ishaq I. Chanda, P.E.
Product Control Unit Supervisor
NOA No. 24-0116.13
Expiration Date: February 13, 2028
Approval Date: February 01, 2024

NOTICE OF ACCEPTANCE: EVIDENCE SUBMITTED

1. EVIDENCE SUBMITTED UNDER PREVIOUS NOA's (CONTINUED)

C. CALCULATIONS

1. Anchor verification calculations and structural analysis, complying with **FBC**, dated 04/28/15, prepared by manufacturer, signed and sealed by Thomas J. Sotos, P.E. *(Submitted under NOA No. 14-0908.02)*
2. Glazing complies with **ASTM E 1300-04/09**.

D. QUALITY ASSURANCE

1. Miami-Dade Department of Regulatory and Economic Resources (RER)

E. MATERIAL CERTIFICATIONS

1. Notice of Acceptance No. **17-0808.02** issued to **Kuraray America, Inc.** for their "**SentryGlas® (Clear and White) Glass Interlayers**" dated 12/28/17, expiring on 07/04/23.
2. Notice of Acceptance No. **19-0305.02** issued to **Kuraray America, Inc.** for their "**Trosifol® Ultraclear, Clear and Color PVB Glass Interlayers**" dated 05/09/19, expiring on 07/08/24.
3. Notice of Acceptance No. **21-0216.01** issued to **Eastman Chemical Company (MA)** for their "**Saflex PVB Interlayers - Clear and Colored for Glass**" dated 04/29/21, expiring on 05/21/26.

F. STATEMENTS

1. Statement letter of conformance to and complying with **FBC 7th Edition (2020)**, dated January 13, 2023, issued by manufacturer, signed and sealed by Thomas J. Sotos, P.E. *(Submitted under NOA No. 23-0119.03)*
2. Statement letter of no financial interest dated January 13, 2023, issued by manufacturer, signed and sealed by Thomas J. Sotos, P.E. *(Submitted under NOA No. 23-0119.03)*
3. Laboratory compliance letters for Test Reports No. **HETI-11-3269** dated 05/16/11, **HETI-11-3270** dated 05/16/11, **HETI-11-3271** dated 10/20/11, **HETI-11-3272** dated 10/20/11, **HETI-11-3274** dated 10/20/11, **HETI-11-3275** dated 10/20/11, **HETI-11-3291** dated 07/15/11, **HETI-11-3292** dated 10/20/11, **HETI-11-3307** dated 10/03/11, **HETI-11-3313** dated 10/20/11, **HETI-11-3314** dated 10/20/11, **HETI-11-3329** dated 01/16/12, **HETI-11-3330** dated 01/16/12, **HETI-12-4040** dated 10/12/12, **HETI-12-4041** dated 10/12/12, **HETI-12-4051** dated 06/13/12, **HETI-12-4052** dated 07/10/12, **HETI-12-4053** dated 09/24/12, **HETI-12-4054** dated 09/24/12, **HETI-12-4064** dated 09/24/12, and **HETI-12-4065** dated 09/24/12, issued by Hurricane Engineering & Testing, Inc., all signed and sealed by Rafael E. Droz-Seda, P.E. *(Submitted under NOA No. 14-0908.02)*



Ishaq I. Chanda, P.E.
Product Control Unit Supervisor
NOA No. 24-0116.13
Expiration Date: February 13, 2028
Approval Date: February 01, 2024

NOTICE OF ACCEPTANCE: EVIDENCE SUBMITTED


1. EVIDENCE SUBMITTED UNDER PREVIOUS NOA's (CONTINUED)

F. STATEMENTS (CONTINUED)

4. Laboratory addendum letter for Test Reports No. **HETI-11-3269, HETI-11-3270, HETI-11-3271, HETI-11-3272, HETI-11-3274, HETI-11-3275, HETI-11-3291, HETI-11-3292, HETI-11-3307, HETI-11-3313, HETI-11-3314, HETI-11-3329, HETI-11-3330, HETI-12-4040, HETI-12-4041, HETI-12-4051, HETI-12-4052, HETI-12-4053, HETI-12-4054, HETI-12-4064 and HETI-12-4065**, dated 01/15/13, issued by Hurricane Engineering & Testing, Inc., signed and sealed by Rafael E. Droz-Seda, P.E.
(Submitted under NOA No. 12-1204.12)
5. Proposal issued by Product Control, dated 03/30/12, signed by Jaime D. Gascon, P.E.
(Submitted under NOA No. 12-1204.12)
6. Proposal issued by Product Control, dated 03/13/08, signed by Ishaq Chanda, P.E.
(Submitted under NOA No. 11-0518.03)
7. Laboratory compliance letters issued by Fenestration Testing Laboratory, Inc., for Test Report No. **FTL-3078** dated 01/10/02, signed and sealed by Luis Figueredo, P.E.
(Submitted under NOA No. 02-1126.04)
8. Laboratory compliance letters issued by Fenestration Testing Laboratory, Inc., for Test Reports No. **FTL-3525** and **FTL-3572** dated 09/09/02, both signed and sealed by Joseph C. Chan, P.E.
(Submitted under NOA No. 02-1126.04)
9. Laboratory compliance letters issued by Fenestration Testing Laboratory, Inc., for Test Reports No. **FTL-3424** dated 04/18/02, **FTL-3425** dated 04/29/02, **FTL-3426** dated 04/26/02, **FTL-3492** dated 06/20/02, **FTL-3493** dated 06/24/02 and **FTL-3516** dated 07/12/02, all signed and sealed by James G. Worth, P.E.
(Submitted under NOA No. 02-1126.04)

G. OTHERS

1. Notice of Acceptance No. **20-0901.06**, issued to Lawson Industries, Inc. for their Series **"SGD-9200 Aluminum Sliding Glass Door (Steel reinforced) – L.M.I."**, approved on 12/03/20 and expiring on 02/13/18.

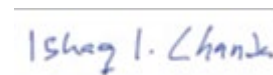

Ishaq I. Chanda, P.E.
Product Control Unit Supervisor
NOA No. 24-0116.13
Expiration Date: February 13, 2028
Approval Date: February 01, 2024

NOTICE OF ACCEPTANCE: EVIDENCE SUBMITTED

2. New Evidence submitted.

A. DRAWINGS

1. Drawing No. **CWS-1223**, titled “7900 Aluminum Sliding Door-Impact”, sheets 1 through 14 of 14, dated DEC 18, 2023, prepared by manufacturer, signed and sealed by Thomas J. Sotos, P.E.

B. TESTS (submitted under NOA# 23-1012.04)

1. None.

C. CALCULATIONS (submitted under NOA# 23-1012.04)

1. None.

D. QUALITY ASSURANCE

1. Miami Dade Department of Regulatory and Economic Resources (RER).

E. MATERIAL CERTIFICATIONS

1. Notice of Acceptance No. **23-0717.30** issued to **Kuraray America, Inc.** for their “**Trosifol® Ultraclear, Clear and Color PVB Glass Interlayers**”, expiring on 07/04/28.

F. STATEMENTS

1. Statement letter of conformance, complying with **FBC 8th Edition (2023)** dated December 18, 2023, issued by manufacturer, signed and sealed by Thomas J. Sotos P.E.

G. OTHER

1. This NOA **revises** NOA # **23-1012.04** (PVT Lawson Industries, Inc.), expiring 06/05/28.
2. Private Label agreement dated January 11, 2024 between Lawson Industries Inc. and Custom Window System Inc., signed respectively by Kevin E. Pine, VP Lawson Industries, Inc. and Kevin E. Pine, VP Custom Window System, Inc.



Ishaq I. Chanda, P.E.
Product Control Unit Supervisor
NOA No. 24-0116.13
Expiration Date: February 13, 2028
Approval Date: February 01, 2024

SEE BELOW NOTE #5.

SEE BELOW NOTE #6.

SEE BELOW NOTE #5.

SEE BELOW NOTE #5.

X-LP or RP-X

2D/2T - XX or
XX-LP or RP-XX or LP-XX-RP

4D/3T - XXXX or 4D/2T
LP-XXXX or RP-XXXX or LP-XXXX-RP

1D/2T - RP
RIGHT POCKET SHOWN
(LEFT POCKET OPPOSITE)

2D/2T

2D/2T - RP
RIGHT POCKET SHOWN
(LEFT POCKET OPPOSITE)

4D/3T

4D/2T

4D/2T - LP/RP

4D/3T - LP
LEFT POCKET SHOWN
(RIGHT POCKET OPPOSITE)

4D/2T - LP
LEFT POCKET SHOWN
(RIGHT POCKET OPPOSITE)

SEE BELOW NOTE #5.

SEE BELOW NOTE #5.


3D/3T - XXX or
LP-XXX or RP-XXX

3D/3T

3D/3T - LP
RIGHT POCKET SHOWN
(LEFT POCKET OPPOSITE)

NOTES:

- 1) REFER TO SHEETS 8 OF 14 FOR GLAZING OPTIONS AND DP CHARTS.
- 2) REFER TO SHEETS 9, 10 & 11 OF 14 FOR TYPICAL CROSS-SECTION DETAILS.
- 3) REFER TO SHEETS 9 OF 14 FOR TYPICAL ANCHORS AND NOTES.
- 4) PANEL STACK CONFIGURATIONS ARE REVERSIBLE.
- 5) FOR POCKET WALLS SEE GENERAL NOTES #15 & 16.

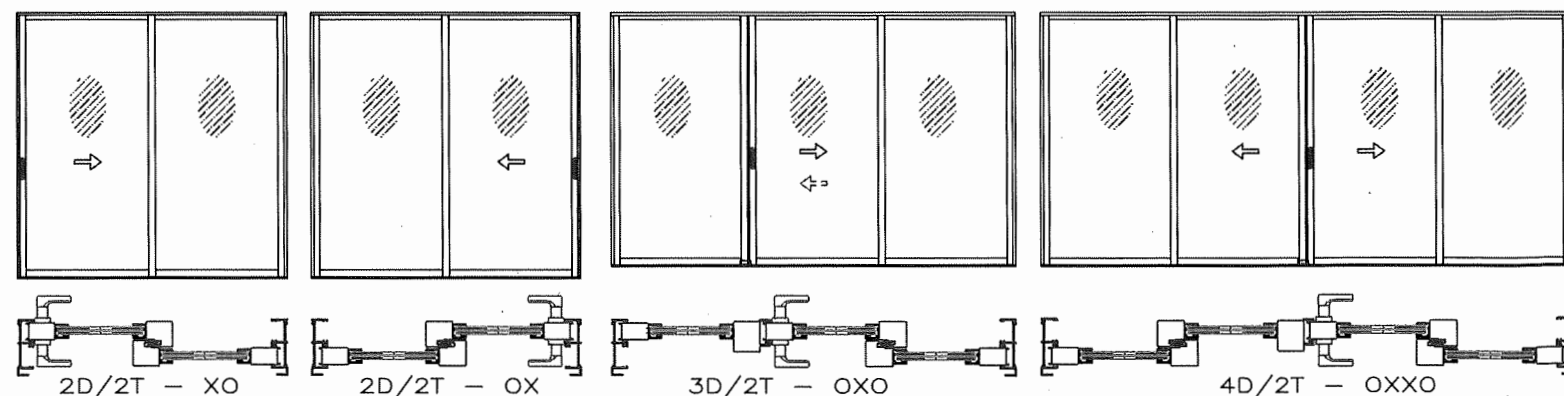

- 1) REFER TO SHEETS 2 OF 14 FOR
FOR GLAZING OPTIONS AND DP CHARTS.
- 2) REFER TO SHEETS 3 & 4 OF 14
FOR TYPICAL CROSS-SECTION DETAILS.
- 3) REFER TO SHEETS 3 OF 14
FOR TYPICAL ANCHORS AND NOTES.

- 1) REFER TO SHEETS 5 OF 14 FOR GLAZING OPTIONS AND DP CHARTS.
- 2) REFER TO SHEETS 6 & 7 OF 14 FOR TYPICAL CROSS-SECTION DETAILS.
- 3) REFER TO SHEETS 6 OF 14 FOR TYPICAL ANCHORS AND NOTES.

- 1.) THIS DOOR SYSTEM IS DESIGNED AND TESTED TO COMPLY W/ THE REQUIREMENTS OF THE FLORIDA BUILDING CODE (2020-7th Edition & 2023-8th Edition) INCLUDING THE HIGH VELOCITY HURRICANE ZONE VELOCITY (HVHZ) AND ASTM 1300-09. THIS PRODUCT IS IMPACT RESISTANT. (SHUTTERS NOT REQUIRED)
- 2.) WOOD BUCKS SHALL BE INSTALLED AND ANCHORED SO THAT THE BUILDING RESISTS THE SUPERIMPOSED LOADS IN ACCORDANCE WITH THE REQUIREMENTS OF THE FLORIDA BUILDING CODE & TO BE REVIEWED BY BUILDING OFFICIAL.
- 3.) ANCHORS SHOWN ABOVE ARE AS PER TEST UNITS. ANCHORS ON ALL DOOR SIZES ARE NOT TO EXCEED THESE MAXIMUM SPACINGS ON CENTER (O.C.) AND AS TABULATED ON SHEETS 2, 5, & 8 of 14.
- 4.) ANCHOR CONDITIONS NOT DESCRIBED IN THESE DRAWING'S ARE TO BE ENGINEERED ON A SITE SPECIFIC BASIS, UNDER A SEPARATE APPROVAL AND TO BE REVIEWED BY BUILDING OFFICIAL.
- 5.) A LOAD DURATION INCREASE IN ALLOWABLE STRESS IS USED IN DESIGN OF ANCHORS INTO WOOD ONLY.
- 6.) DOORS ARE QUALIFIED FOR USE WITH SINGLE GLAZE H.S. LAMINATED GLASS TYPES TABULATED HEREIN (SEE SHEETS # 2, 5, & 8).
- 7.) FOR OPTIONAL FRAME INSTALLATION DETAILS SEE SHEETS 3, 4, 6, 7, 9, 10, & 11 OF 14.
- 8.) EXT. & INT. FALSE COLONIAL MUNTINS ARE OPTIONAL & AND TO BE APPLIED W/ SILICONE.
- 9.) WOOD BUCKS IN CONTACT WITH CONCRETE MUST BE PRESSURE TREATED AND ANCHORED (BY OTHERS), PRIOR TO DOOR INSTALLATION. WOOD BUCKS TO BE ANCHORED IN COMPLIANCE WITH THE FLORIDA BUILDING CODE CHAPTER 24.
- 10.) APPROVAL APPLIES TO TWO TRACK AND THREE TRACK DOORS WITH FIXED PANELS, ALL MOVING PANELS, INCLUDING WITH OR WITHOUT (LH-RH) POCKETS.
- 11.) MULLION DOORS WITH OTHER TYPES OF MIAMI-DADE COUNTY APPROVED PRODUCTS USING A MIAMI-DADE COUNTY APPROVED MULLION IN BETWEEN ARE ACCEPTABLE BUT THE LOWER DESIGN PRESSURE FROM THE DOORS OR MULLION APPROVAL WILL APPLY TO THE ENTIRE MULLED SYSTEM.
- 12.) FOR METAL ATTACHMENT DETAILS & NOTES SEE SHEETS # 3, 4, 6, 7, 9, 10, & 11 OF 14.
- 13.) ALL METAL/STEEL IN CONTACT WITH ALUMINUM OR OTHER DISSIMILAR MATERIALS TO BE PAINTED OR PLATED AND SHALL MEET THE FLORIDA BUILDING CODE.
- 14.) POCKET DOOR CONFIGURATIONS ARE AS SHOWN ON SHEET 8 OF 14, REFER TO SHEET 11 OF 14 FOR ADDITIONAL DETAILS.
- 15.) POCKET WALLS ARE NOT PART OF THIS APPROVAL.
- 16.) POCKET WALLS SHALL BE UNDER SEPARATE APPROVAL AND TO BE REVIEWED BY THE ENGINEER OF RECORD (EOR).



DOORS GLAZED WITH LAMINATED GLASS RATED FOR
LARGE MISSILE IMPACT AND REQUIRE NO SHUTTERS.

By Ishaq I. Chanks
Miami-Dade Product Control



DESIGN LOAD CAPACITY - PSF (STD. 2 1/4" SILL)									
NOMINAL DOOR SIZES WIDTH FT./IN.		GLASS TYPE 'A'		GLASS TYPE 'B'		GLASS TYPE 'C'		GLASS TYPE 'D'	
		EXT. (+)	INT. (-)	EXT. (+)	INT. (-)	EXT. (+)	INT. (-)	EXT. (+)	INT. (-)
5/0 (NO STEEL)	6/8	56.7	95.0	56.7	65.0	56.7	85.0	56.7	75.0
6/0 (NO STEEL)	6/8	56.7	95.0	56.7	65.0	56.7	85.0	56.7	75.0
8/0 (WITH STEEL)	6/8	56.7	85.0	56.7	70.0	56.7	78.8	56.7	68.8
8/0 (WITH STEEL)	8/0	56.7	65.0	56.7	65.0	X	X	X	X

DESIGN LOAD CAPACITY - PSF (WITH 3" SILL RISER)									
NOMINAL DOOR SIZES WIDTH FT./IN.		GLASS TYPE 'A'		GLASS TYPE 'B'		GLASS TYPE 'C'		GLASS TYPE 'D'	
		EXT. (+)	INT. (-)	EXT. (+)	INT. (-)	EXT. (+)	INT. (-)	EXT. (+)	INT. (-)
5/0 (NO STEEL)	6/8	76.7	95.0	65.0	65.0	76.7	85.0	75.0	75.0
6/0 (NO STEEL)	6/8	76.7	95.0	65.0	65.0	76.7	85.0	75.0	75.0
8/0 (WITH STEEL)	6/8	76.7	85.0	70.0	70.0	76.7	78.8	68.8	68.8
8/0 (WITH STEEL)	8/0	65.0	65.0	65.0	65.0	X	X	X	X

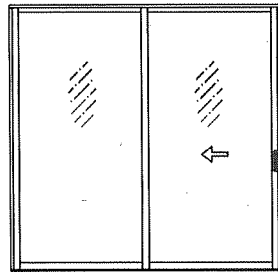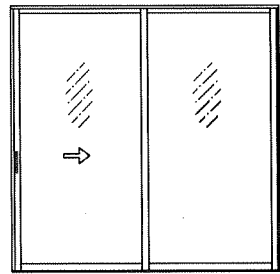

XO OX
APPROVED CONFIGURATIONS

(FOR PANEL STACK CONFIGURATIONS SEE SHEET 1.)


NOTES:

- 1) REFER TO SHEETS 3 & 4 OF 14 FOR TYPICAL CROSS-SECTION DETAILS.
- 2) REFER TO SHEETS 3 OF 14 FOR TYPICAL ANCHORS AND NOTES.


MAX. D.L.O.:
6/0 X 6/8 = 32-3/4" X 74-3/4"
8/0 X 6/8 = 44-3/4" X 74-3/4"
8/0 X 8/0 = 44-3/4" X 90-3/4"

LAMINATED GLASS
LARGE MISSILE IMPACT


DOORS GLAZED WITH LAMINATED GLASS RATED FOR
LARGE MISSILE IMPACT AND REQUIRE NO SHUTTERS.

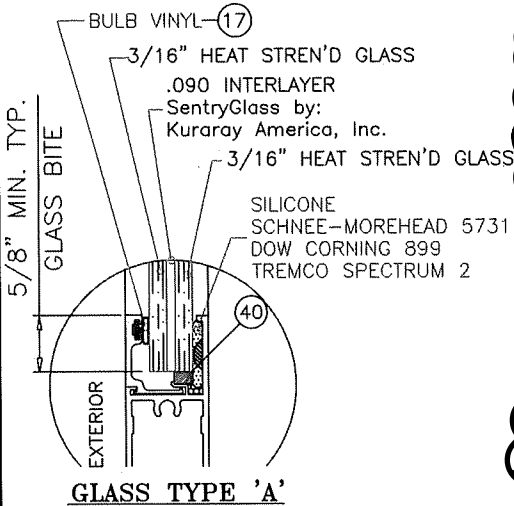


GLASS TYPE 'A'

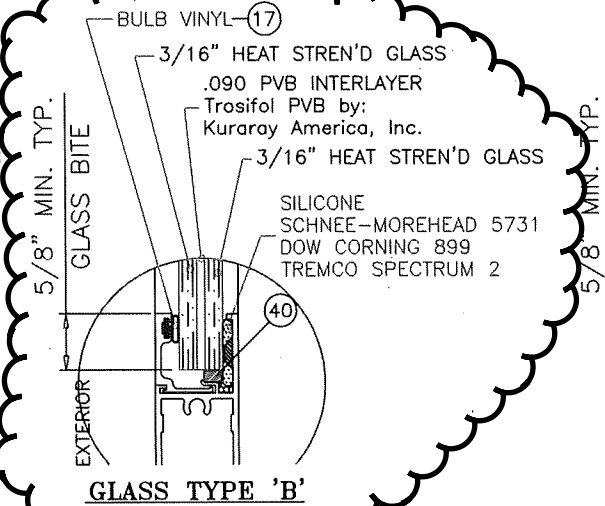

GLASS TYPE 'B'

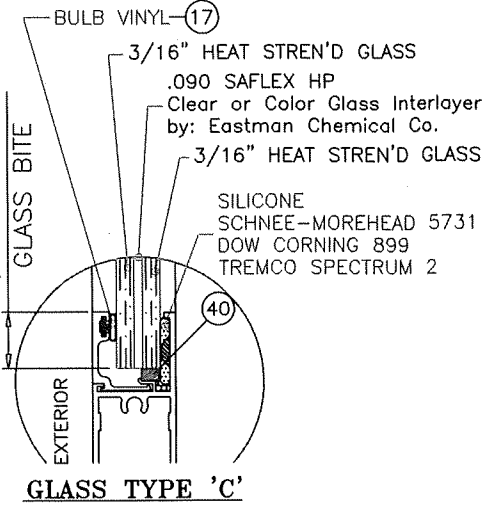


GLASS TYPE 'C'

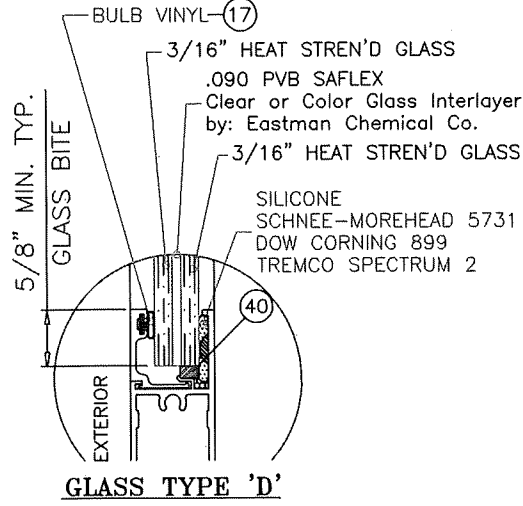

GLASS TYPE 'D'

GLAZING DETAILS

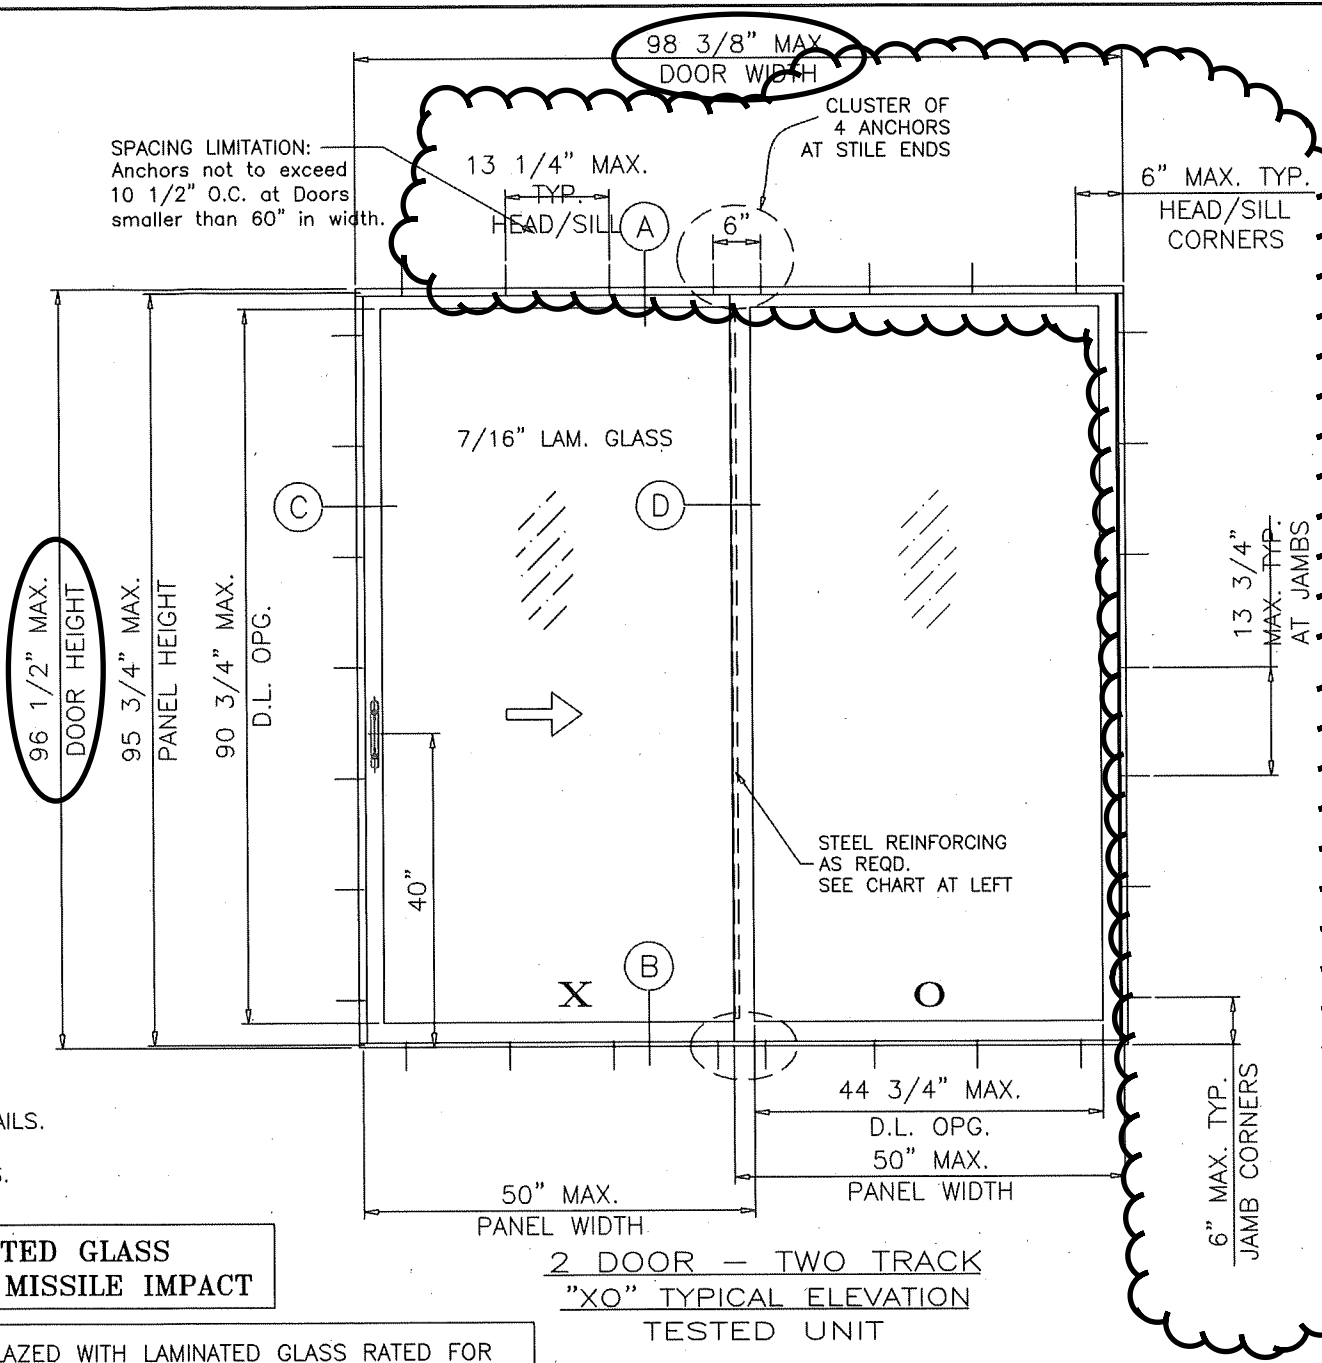

2 DOOR - TWO TRACK
"XO" TYPICAL ELEVATION
TESTED UNIT


PRODUCT REVISED
as complying with the Florida
Building Code
NOA-No. 24-0116.13
Expiration Date 02/13/2028
By Ishag I. Chank
Miami-Dade Product Control



1900 SW 44TH AVE.
OCALA, FLORIDA 34474
WWW.CWS.CC

7900 ALUMINUM
SLIDING DOOR
- IMPACT


REVISIONS		NO.	DESCRIPTION	BY	DATE

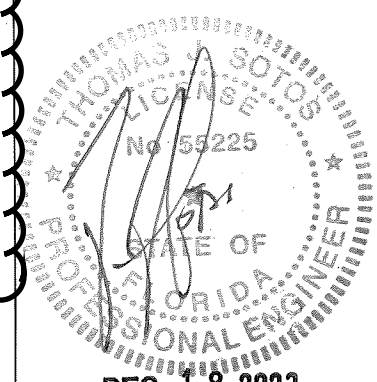

DATE **DEC 18 2023**

THOMAS J. SOTOS, P.E.
FL. P.E. LIC. # 55225



SHEET DESCRIPTION: APPROVED ELEVATIONS, GENERAL NOTES, GLAZING DETAILS & DP LOAD CHARTS	
DRAWN BY: N. Erazo	DATE: 12/18/2023
REV. BY: ---	DATE: ---
DWG #: CWS-1223	REV #:
SCALE: ---	SHEET 2 OF 14

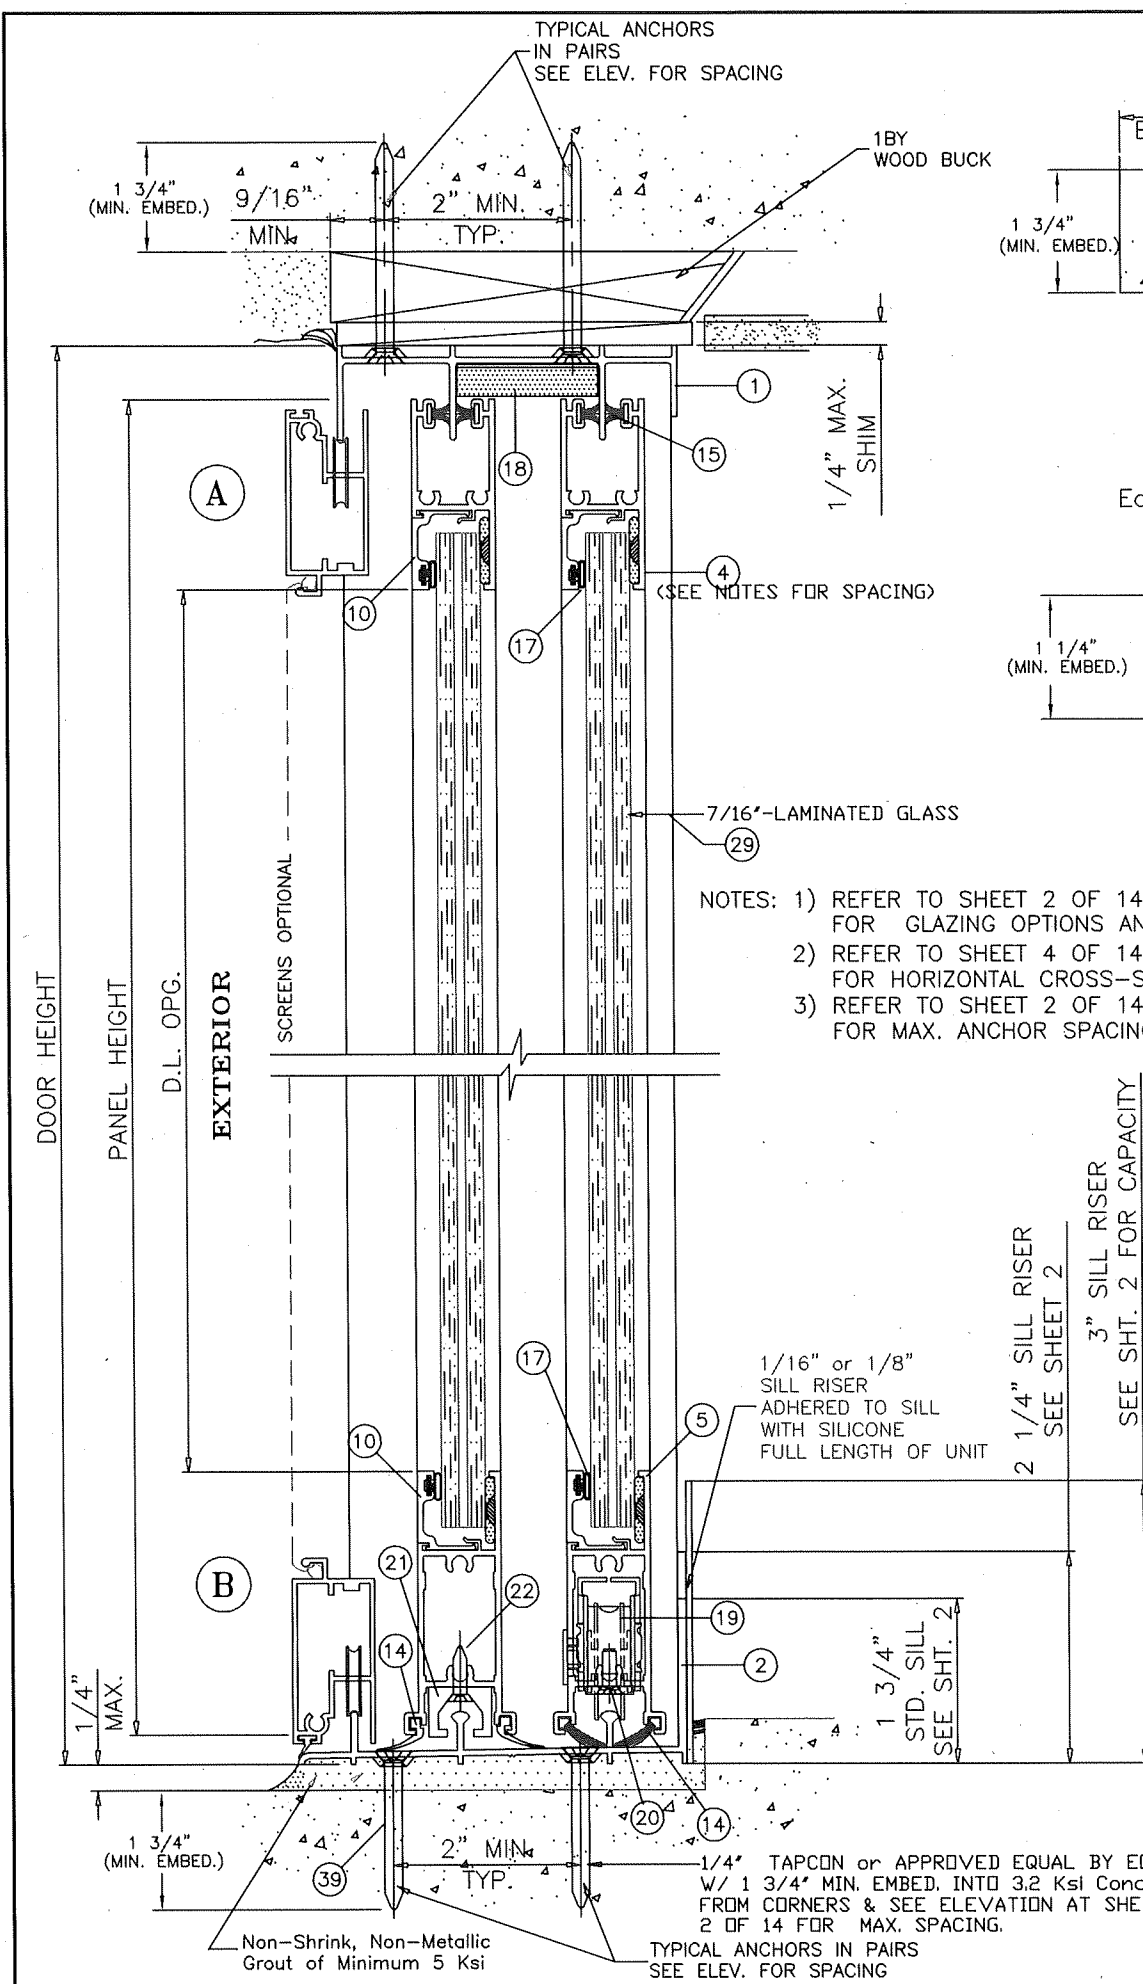

- NOTES: 1) REFER TO SHEET 2 OF 14 FOR GLAZING OPTIONS AND DP CHARTS.
 2) REFER TO SHEET 4 OF 14 FOR HORIZONTAL CROSS-SECTION DETAILS.
 3) REFER TO SHEET 2 OF 14 FOR MAX. ANCHOR SPACINGS.

2 1/4" SILL RISER SEE SHEET 2
 3" SILL RISER SEE SHT. 2 FOR CAPACITY

PRODUCT REVISED
 as complying with the Florida Building Code
NOA-No. 24-0116.13
Expiration Date 02/13/2028
 By Ishaq I. Chandra
Miami-Dade Product Control

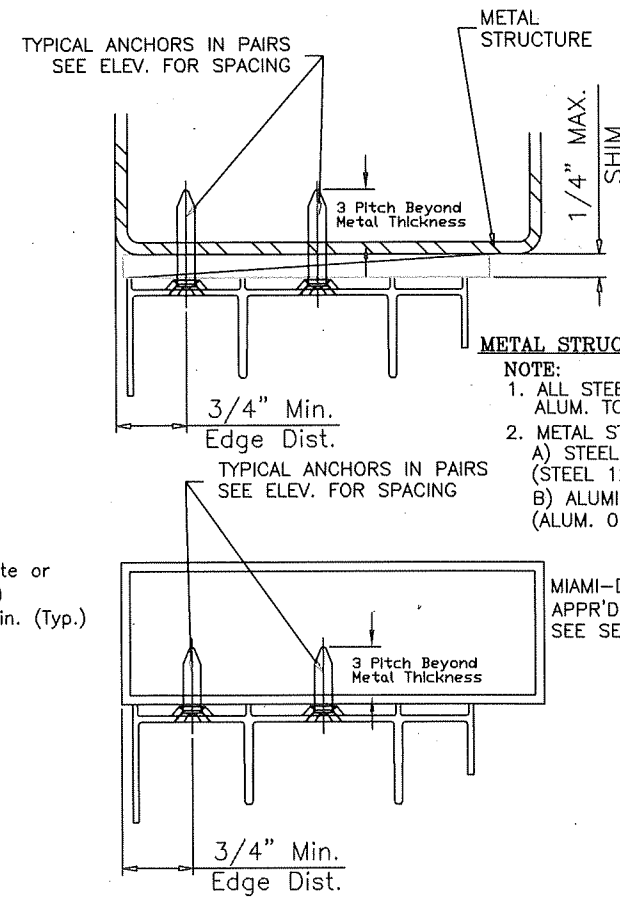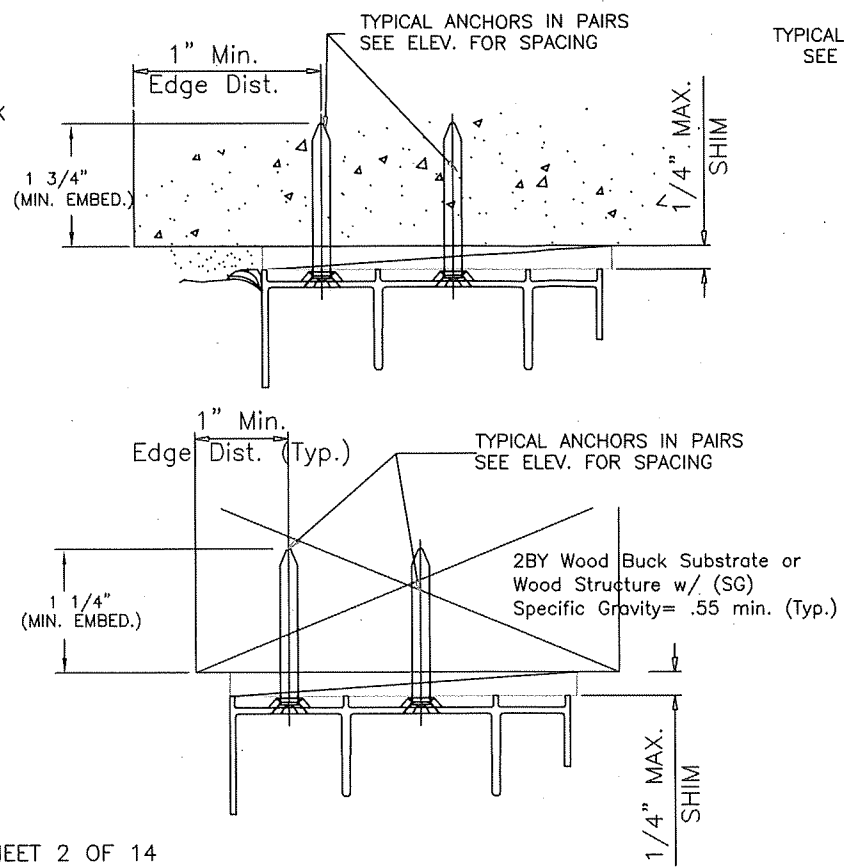

METAL STRUCTURE ATTACHMENT DETAILS
 NOTE:
 1. ALL STEEL IN CONTACT WITH ALUM. TO BE PAINTED OR PLATED.
 2. METAL STRUCTURES:
 A) STEEL : Fy = 36 KSI MIN. (STEEL 12 GA. MIN. THICK = 0.105")
 B) ALUMINUM : 6063-T5 MIN. (ALUM. 0.078" MIN. THICK)

WOOD BUCKS AND METAL STRUCTURES NOT BY CWS MUST SUPPORT LOADS IMPOSED BY GLAZING SYSTEM AND TRANSFER THEM TO THE BUILDING STRUCTURE.

TYPICAL ANCHORS: SEE ELEV. AT SHEET 8 FOR SPACING

ANCHOR TYPE CHART IN CONC. or MASONRY (min.)					
ANCHOR OPTIONS	HEAD-SILL	JAMB	Embedment	Edge Dist.	Concrete
ELCO ULTRACON	1/4"	1/4"	1 3/4"	1"	2.85 Ksi
BUILDEX	1/4"	-	1 3/4"	4"	3.2 Ksi
BUILDEX	-	3/16"	1 3/4"	3"	3.2 Ksi
ANCHOR TYPE CHART IN 2X WOOD BUCK (min.)					
ANCHOR OPTIONS	HEAD-SILL	JAMB	Embedment	Edge Dist.	2x Wood
ELCO ULTRACON	1/4"	1/4"	1 1/4"	1"	.55 SG
BUILDEX	1/4"	1/4"	1 1/4"	1"	.55 SG
S.M.S. (Into 2X)	#12	#12	1 1/4"	1"	.55 SG

1/4" DRILLFLEX SELF DRILLING SCREWS
 INTO METAL STRUCTURES
 STEEL : 12 GA. MIN. (Fy = 36 KSI MIN.)
 ALUMINUM : 1/8" THK. MIN. (6063-T5 MIN.)
 (STEEL IN CONTACT WITH ALUMINUM TO BE PLATED OR PAINTED)
#12 SMS
 INTO APPROVED MULLIONS (NO SHIM SPACE)
TYPICAL EDGE DISTANCE
 (1/4") INTO CONCRETE AND MASONRY = 1" MIN. (ELCO ULTRACON)
 (1/4") INTO CONCRETE AND MASONRY = 4" MIN. (ITW BUILDEX)
 (3/16") INTO CONCRETE AND MASONRY = 3" MIN. (ITW BUILDEX)
 INTO WOOD STRUCTURE = 1" MIN.
 INTO METAL STRUCTURE = 3/4" MIN.
SEALANTS:
 FRAME AND VENT CORNERS AND INSTALLATION SCREWS AT SILL SEALED WITH WHITE/ALUMINUM COLORED SEALANT.

1900 SW 44TH AVE.
 Ocala, Florida 34474
 WWW.CWS.CC

7900 ALUMINUM SLIDING DOOR - IMPACT



NO.	DESCRIPTION	BY	DATE	REVISIONS

DATE: **DEC 18 2023**

THOMAS J. SOTOS, P.E.
 FL. P.E. LIC. # 55225



SHEET DESCRIPTION:
 2 TRACK VERTICAL CROSS SECTIONS, DETAILS & ANCHOR NOTES


DRAWN BY: N. Erazo	DATE: 12/18/2023
REV. BY: ---	DATE: ---
DWG #: CWS-1223	REV #:
SCALE: ---	SHEET 3 OF 14

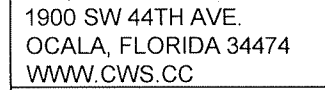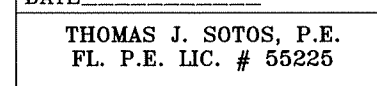[illegible]


PRODUCT REVISED
as complying with the Florida
Building Code
NOA-No. 24-0116.13
Expiration Date 02/13/2028
By Ishag I. Chank
Miami-Dade Product Control

DRAWN BY: N. Erazo		DATE: 12/18/2023	
REV. BY: ---		DATE: ---	
DWG #: CWS-1223		REV #:	
SCALE: ---		SHEET 4 OF 14	

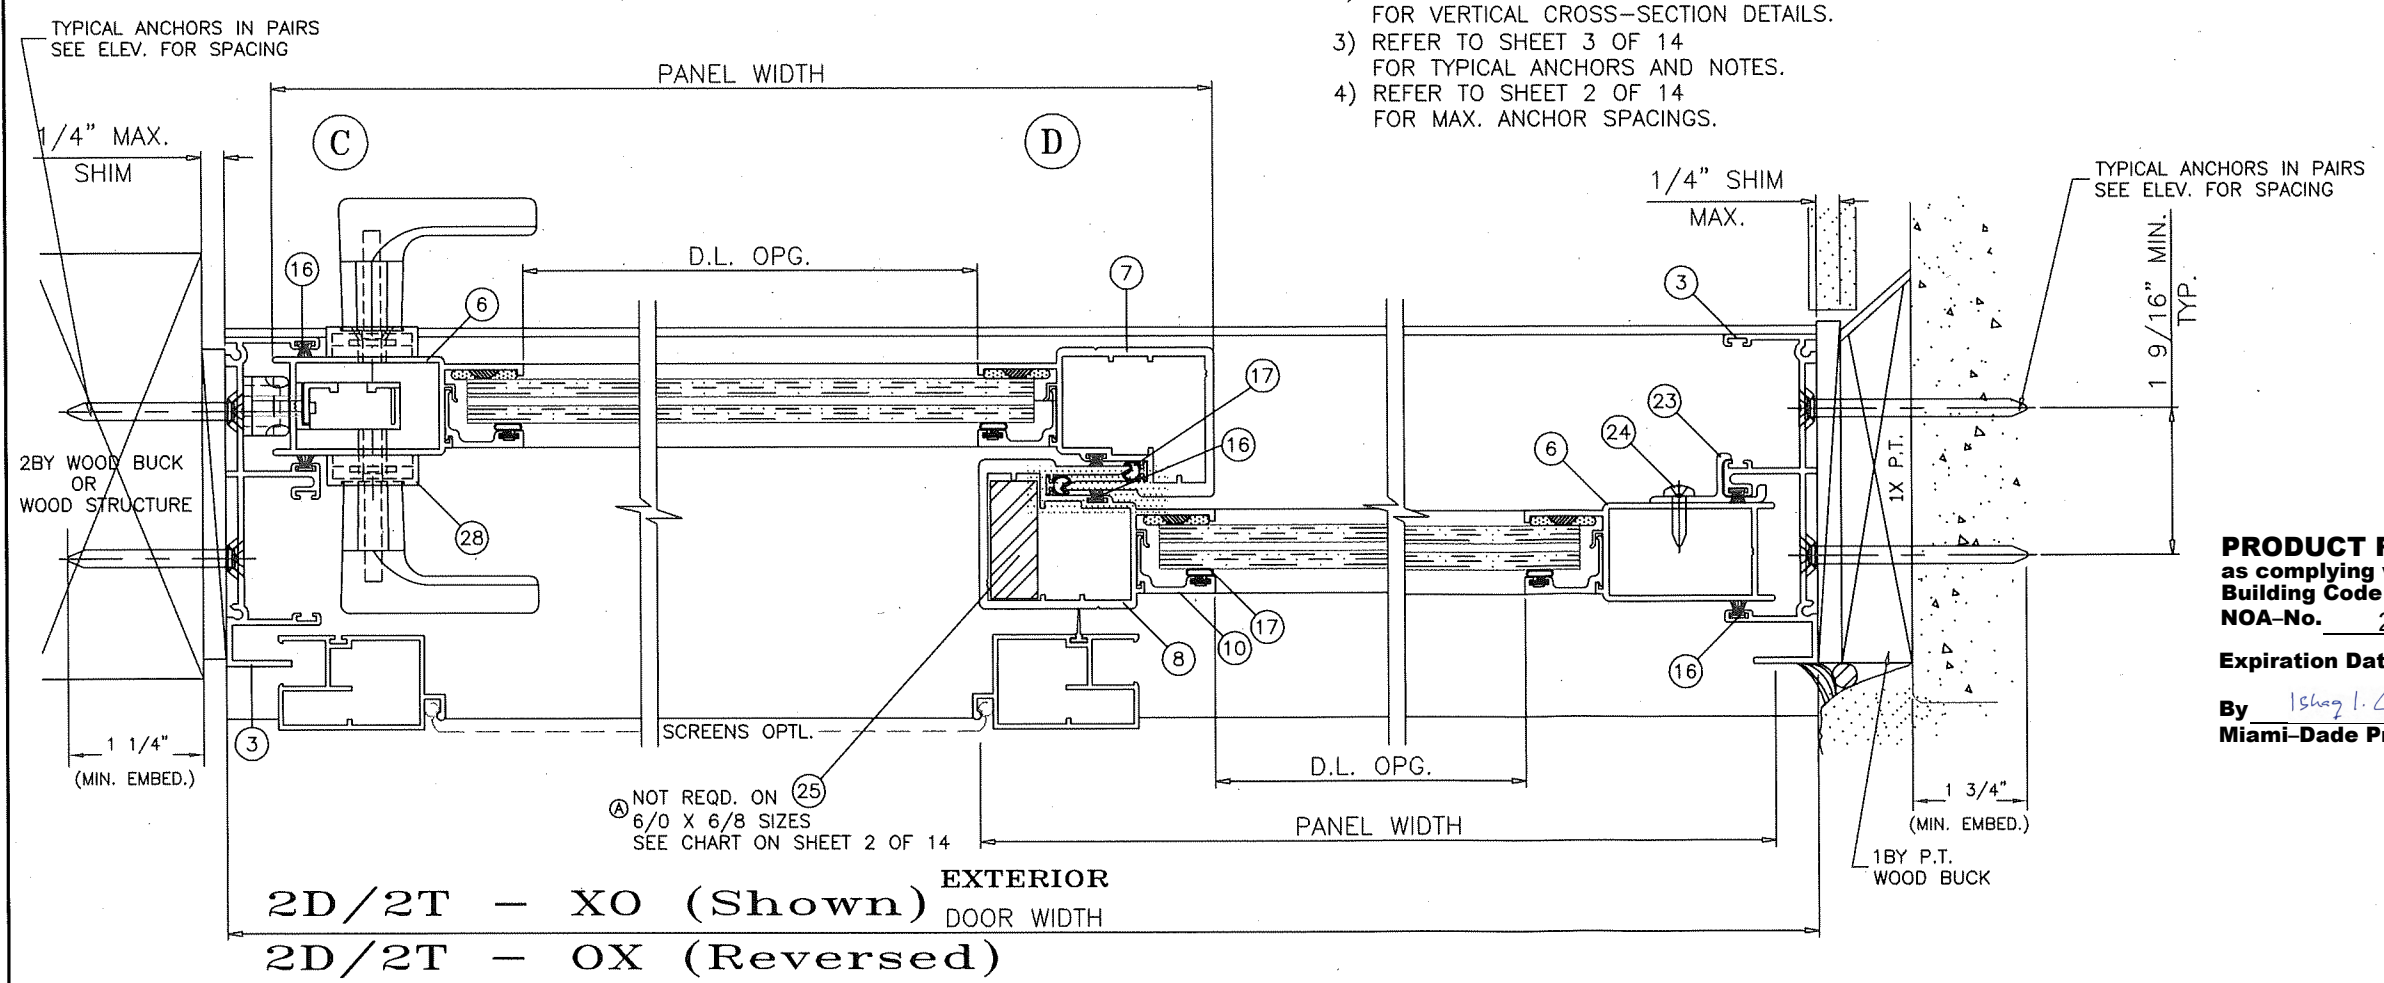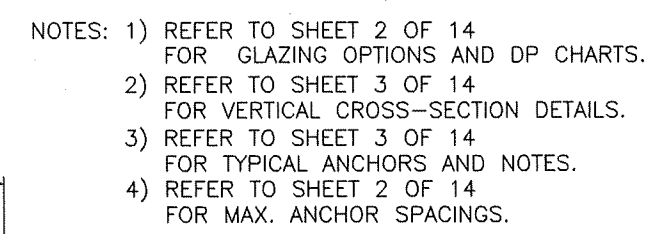

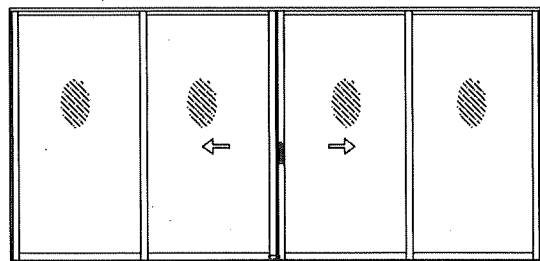


OXXO

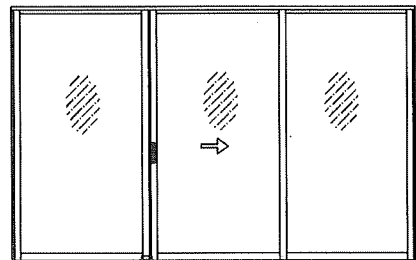


OXO

APPROVED CONFIGURATIONS

(FOR PANEL STACK CONFIGURATIONS SEE SHEET 1.)

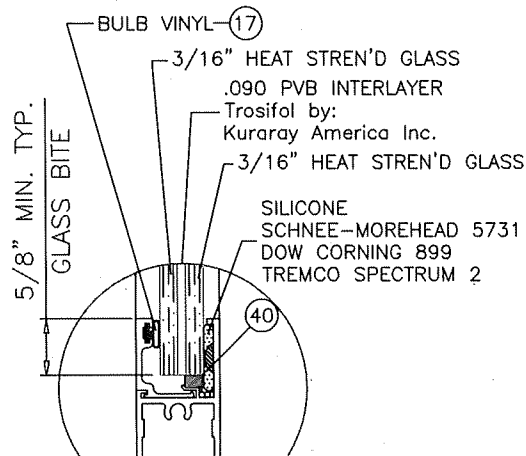


GLASS TYPE 'B'

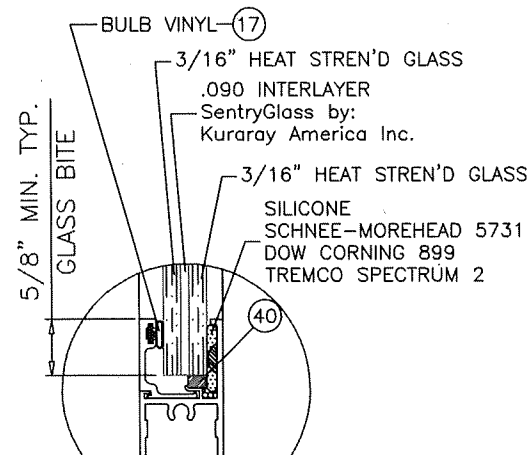

GLASS TYPE 'A'

GLAZING DETAILS

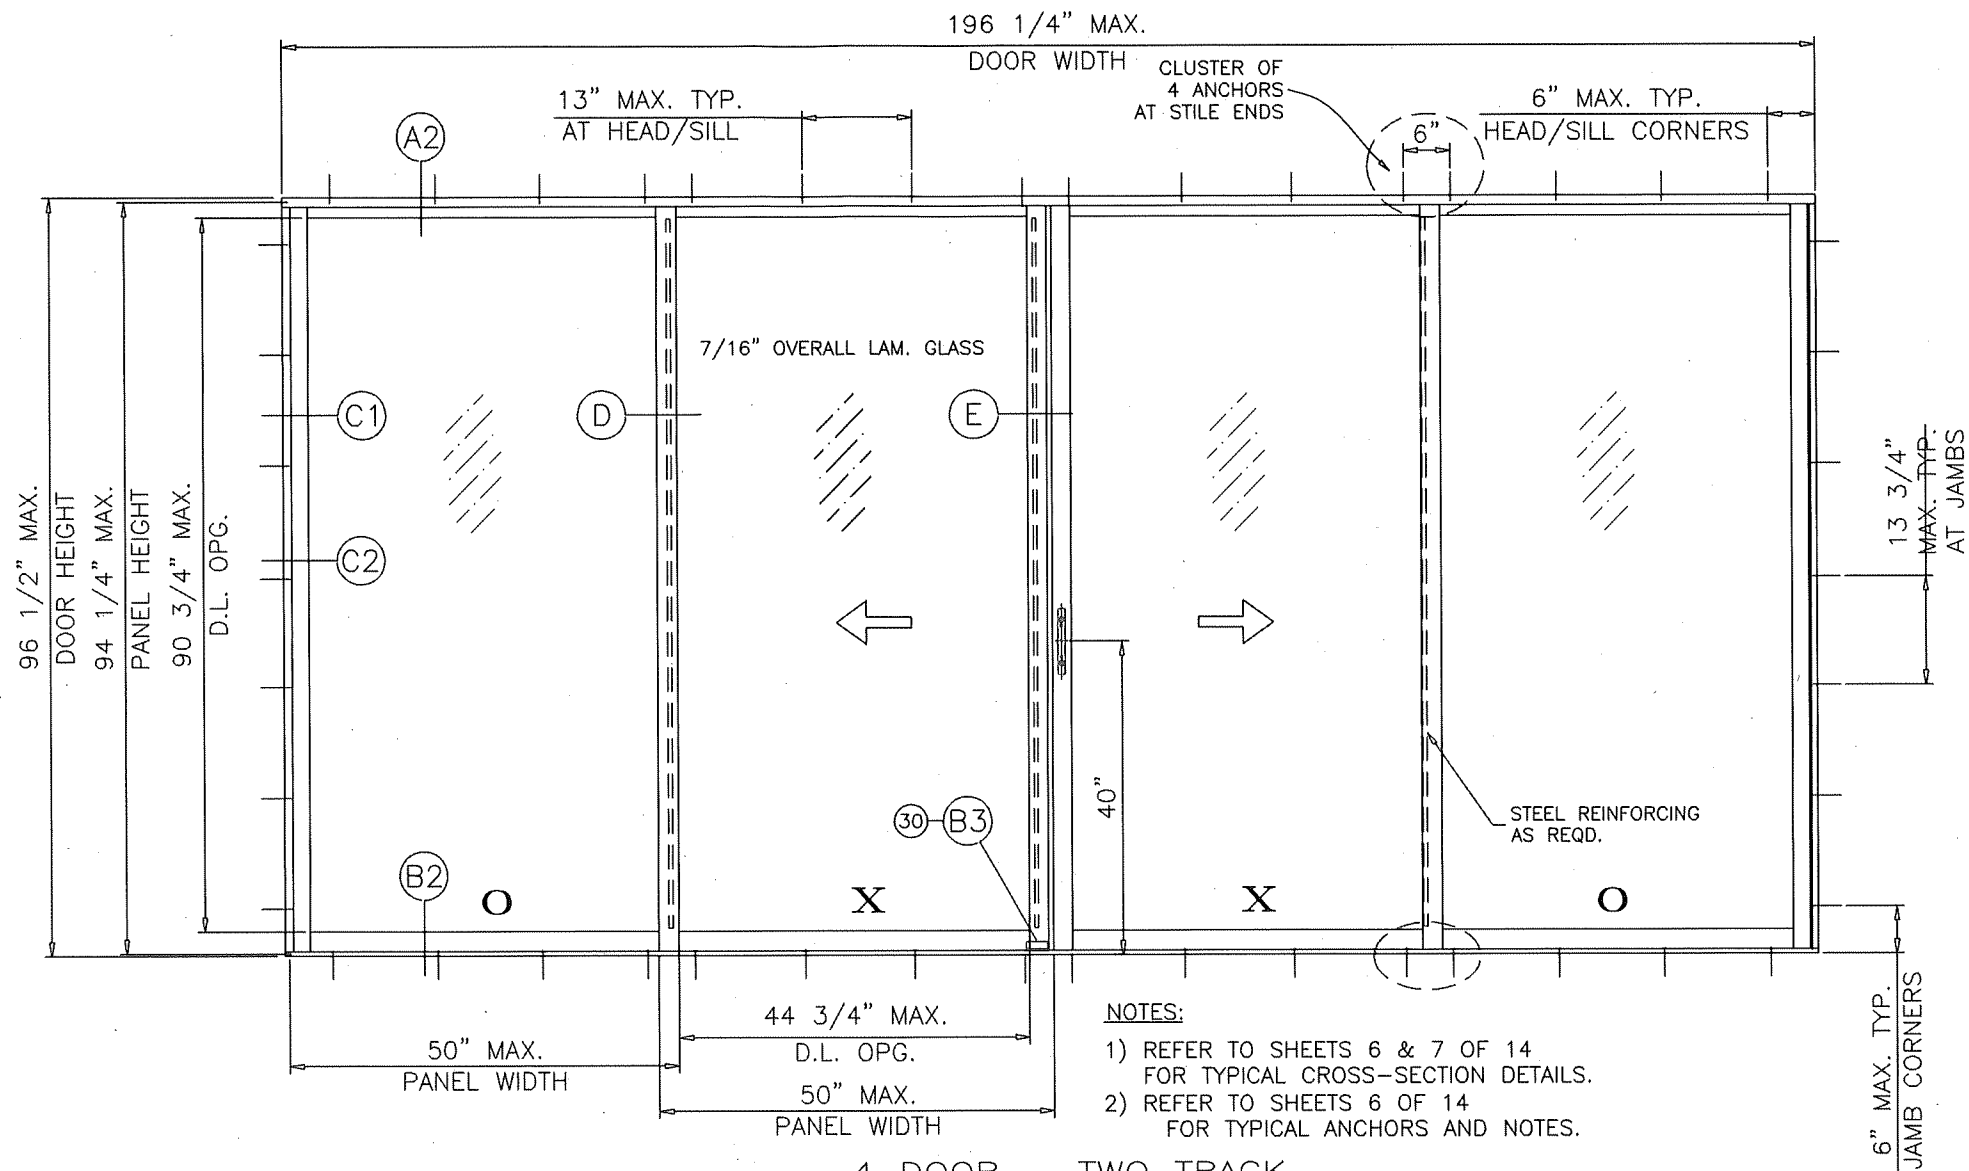

NOTES:

- 1) REFER TO SHEETS 6 & 7 OF 14 FOR TYPICAL CROSS-SECTION DETAILS.
- 2) REFER TO SHEETS 6 OF 14 FOR TYPICAL ANCHORS AND NOTES.

4 DOOR - TWO TRACK
"OXXO" TYPICAL ELEVATION
TESTED UNIT

LAMINATED GLASS
LARGE MISSILE IMPACT

DOORS GLAZED WITH LAMINATED GLASS RATED FOR
LARGE MISSILE IMPACT AND REQUIRE NO SHUTTERS.

DESIGN LOAD CAPACITY - PSF GLASS TYPES 'A' OR 'B'

PANEL WIDTH NOMINAL FT./IN.	DOOR HEIGHT FT./IN.	STANDARD SILL		2-1/4" RISER		3" RISER	
		EXT. (+)	INT. (-)	EXT. (+)	INT. (-)	EXT. (+)	INT. (-)
2/6	6/8	40.7	60.0	56.7	60.0	60.0	60.0
3/0		40.7	60.0	56.7	60.0	60.0	60.0
3/6		40.7	60.0	56.7	60.0	60.0	60.0
4/0		40.7	60.0	56.7	60.0	60.0	60.0
4/6		40.7	60.0	56.7	60.0	60.0	60.0
4/11		40.7	60.0	56.7	60.0	60.0	60.0
2/6	8/0	40.7	60.0	56.7	60.0	60.0	60.0
3/0		40.7	60.0	56.7	60.0	60.0	60.0
3/6		40.7	60.0	56.7	60.0	60.0	60.0
4/0		40.7	60.0	56.7	60.0	60.0	60.0

PRODUCT REVISED as complying with the Florida Building Code

NOA-No. 24-0116.13

Expiration Date 02/13/2028

By Ishag I. Chank
Miami-Dade Product Control

PANEL MAX. D.L.O.:


3/0 X 6/8 = 32-3/4" X 74-3/4"
4/0 X 6/8 = 44-3/4" X 74-3/4"
4/11 X 6/8 = 55-3/4" X 74-3/4"
3/0 X 8/0 = 32-3/4" X 90-3/4"
4/0 X 8/0 = 44-3/4" X 90-3/4"



1900 SW 44TH AVE.
OCALA, FLORIDA 34474
WWW.CWS.CC

7900 ALUMINUM SLIDING DOOR - IMPACT

NO.	DESCRIPTION	BY	DATE

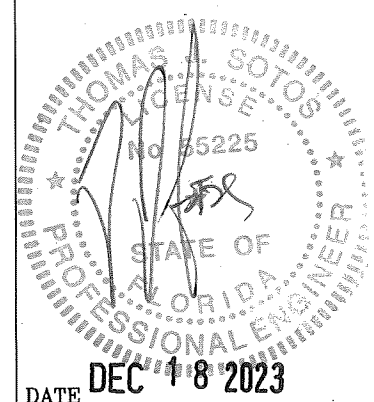

THOMAS J. SOTOS, P.E.
FL. P.E. LIC. # 55225


SHEET DESCRIPTION:
APPROVED ELEVATIONS,
GENERAL NOTES,
GLAZING DETAILS &
DP LOAD CHARTS

DRAWN BY: N. Erazo
DATE: 12/18/2023

REV. BY: ---
DATE: ---

DWG #: CWS-1223
REV #:

SCALE: ---
SHEET 5 OF 14

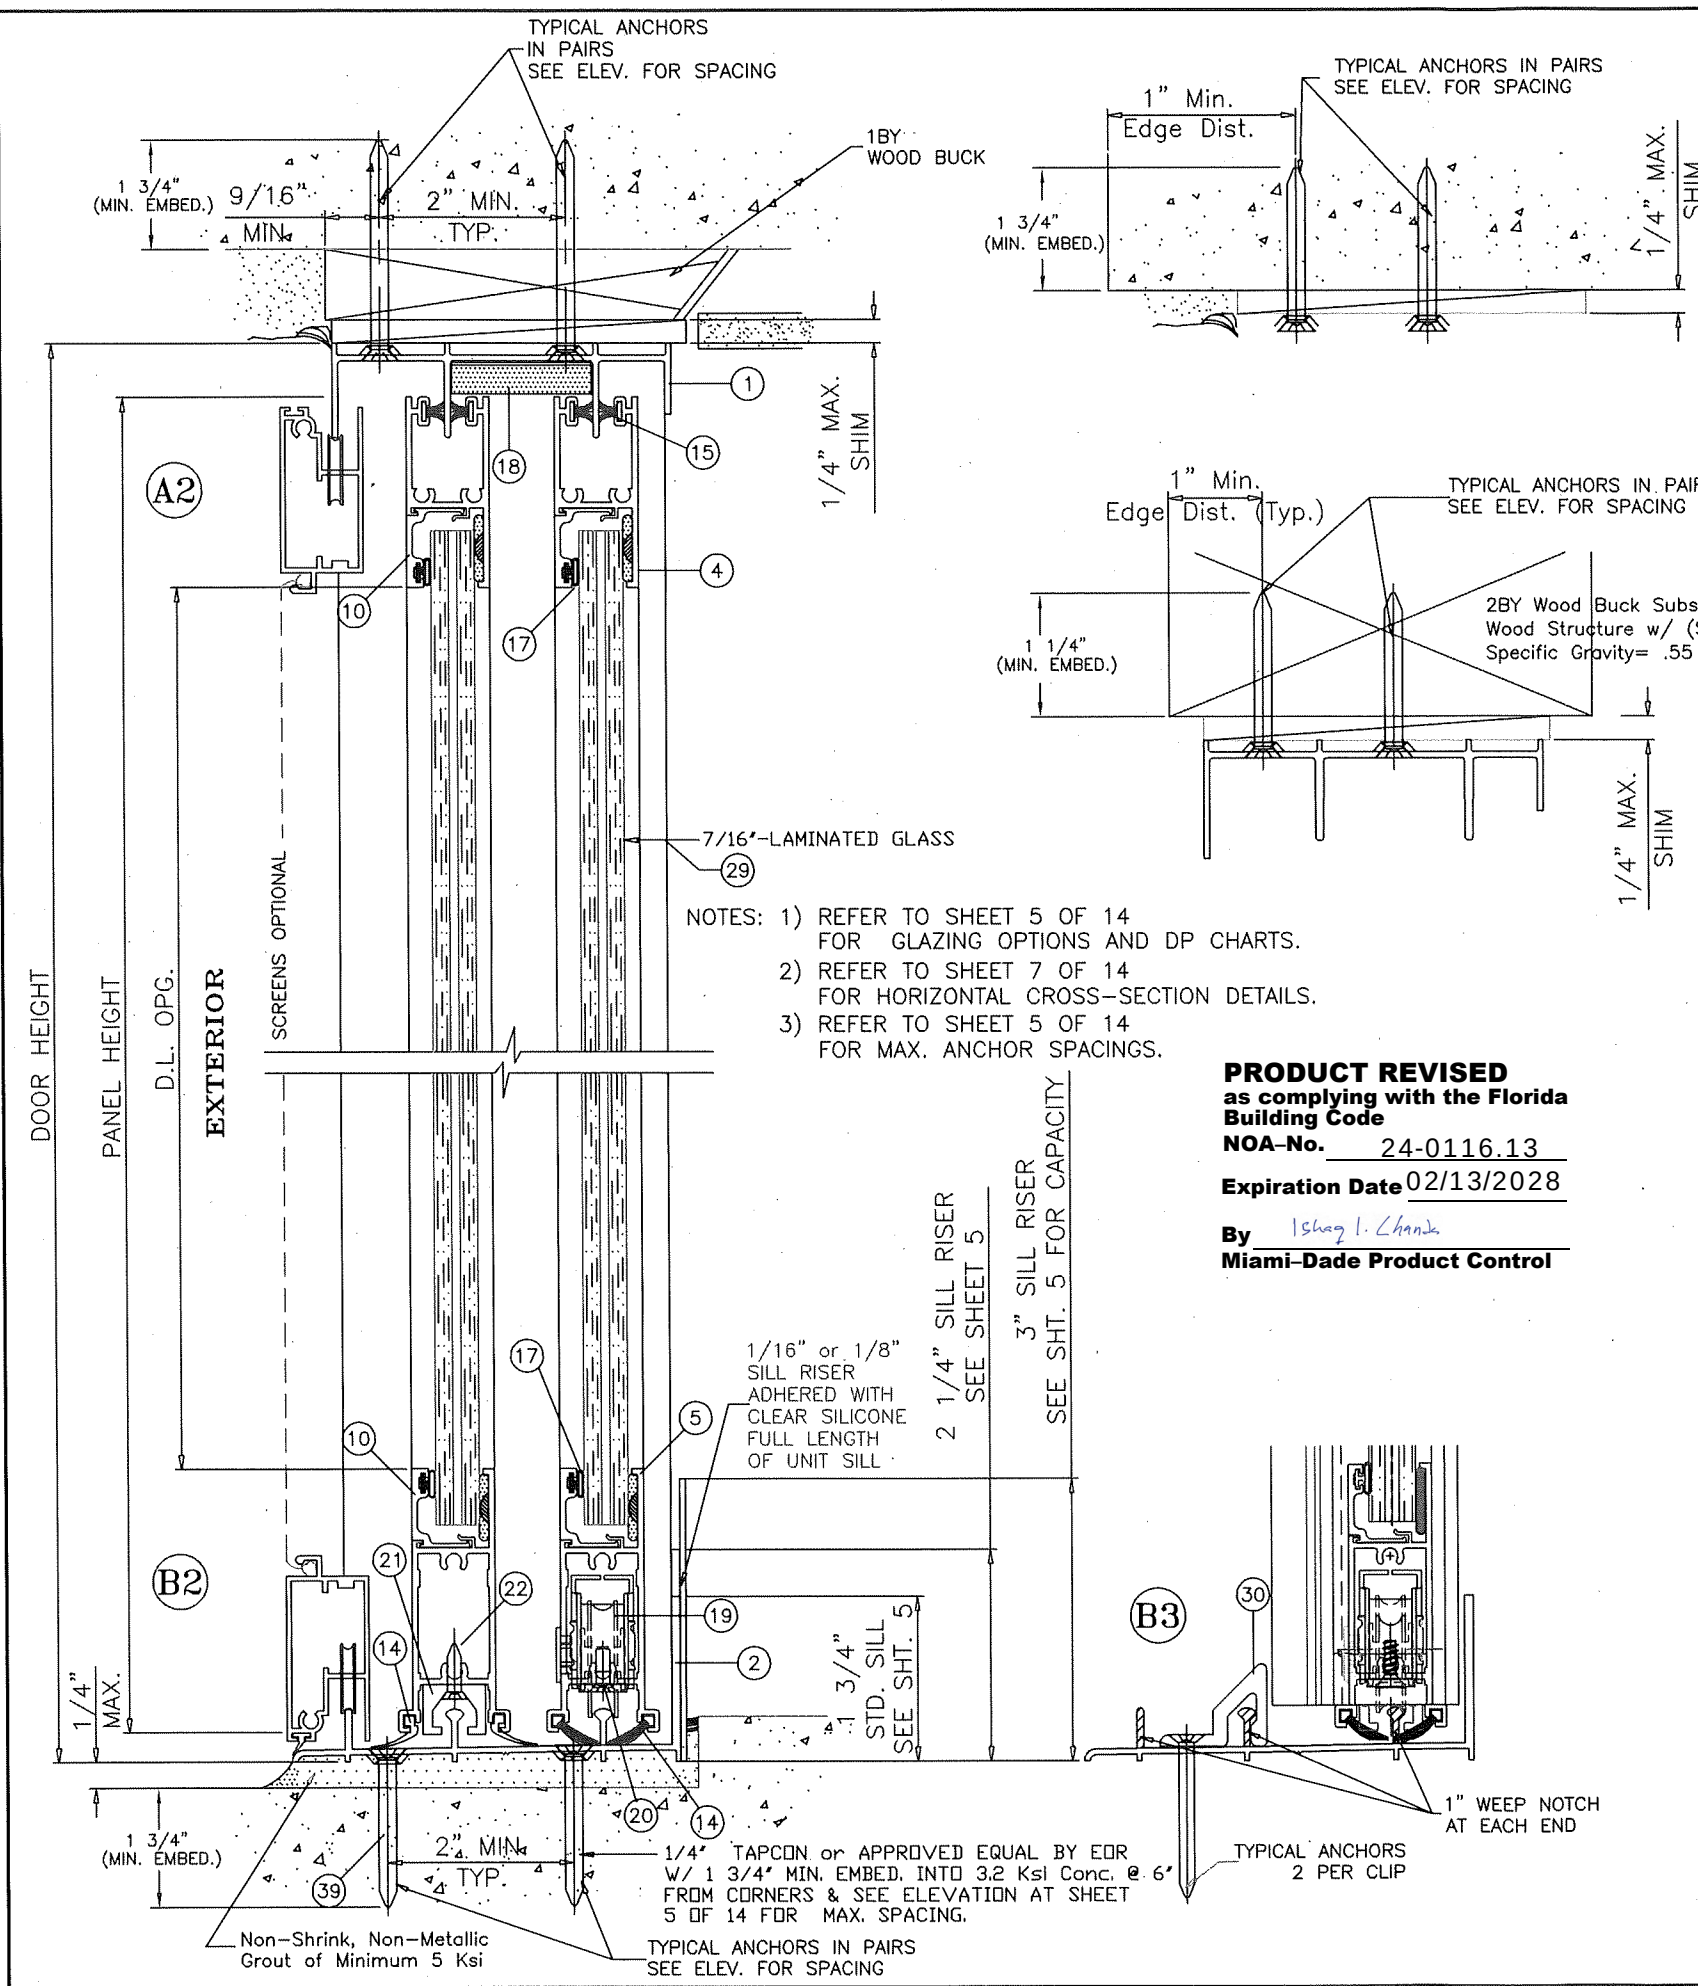

- NOTES: 1) REFER TO SHEET 5 OF 14 FOR GLAZING OPTIONS AND DP CHARTS.
2) REFER TO SHEET 7 OF 14 FOR HORIZONTAL CROSS-SECTION DETAILS.
3) REFER TO SHEET 5 OF 14 FOR MAX. ANCHOR SPACINGS.

PRODUCT REVISED
as complying with the Florida Building Code
NOA-No. 24-0116.13
Expiration Date 02/13/2028
By *Ishaq I. Chanak*
Miami-Dade Product Control

WOOD BUCKS AND METAL STRUCTURES NOT BY CWS.
MUST SUPPORT LOADS IMPOSED BY GLAZING SYSTEM AND TRANSFER THEM TO THE BUILDING STRUCTURE.

TYPICAL ANCHORS: SEE ELEV. AT SHEET 8 FOR SPACING

ANCHOR TYPE CHART IN CONC. or MASONRY (min.)					
ANCHOR OPTIONS	HEAD-SILL	JAMB	Embedment	Edge Dist.	Concrete
ELCO ULTRACON	1/4"	1/4"	1 3/4"	1"	2.85 Ksi
BUILDEX	1/4"	-	1 3/4"	4"	3.2 Ksi
BUILDEX	-	3/16"	1 3/4"	3"	3.2 Ksi
ANCHOR TYPE CHART IN 2X WOOD BUCK (min.)					
ANCHOR OPTIONS	HEAD-SILL	JAMB	Embedment	Edge Dist.	2x Wood
ELCO ULTRACON	1/4"	1/4"	1 1/4"	1"	.55 SG
BUILDEX	1/4"	1/4"	1 1/4"	1"	.55 SG
S.M.S. (Into 2X)	#12	#12	1 1/4"	1"	.55 SG

1/4" DRILLFLEX SELF DRILLING SCREWS
INTO METAL STRUCTURES
STEEL : 12 GA. MIN. (Fy = 36 KSI MIN.)
ALUMINUM : 1/8" THK. MIN. (6063-T5 MIN.)
(STEEL IN CONTACT WITH ALUMINUM TO BE PLATED OR PAINTED)
#10 SMS
INTO APPROVED MULLIONS (NO SHIM SPACE)
TYPICAL EDGE DISTANCE
(1/4") INTO CONCRETE AND MASONRY = 1" MIN. (ELCO ULTRACON)
(1/4") INTO CONCRETE AND MASONRY = 4" MIN. (ITW BUILDEX)
(3/16") INTO CONCRETE AND MASONRY = 3" MIN. (ITW BUILDEX)
INTO WOOD STRUCTURE = 1" MIN.
INTO METAL STRUCTURE = 3/4" MIN.
SEALANTS:
FRAME AND VENT CORNERS AND INSTALLATION SCREWS AT SILL
SEALED WITH WHITE/ALUMINUM COLORED SEALANT.

METAL STRUCTURE ATTACHMENT DETAILS
NOTE:
1. ALL STEEL IN CONTACT WITH ALUM. TO BE PAINTED OR PLATED.
2. METAL STRUCTURES:
A) STEEL : Fy = 36 KSI MIN. (STEEL 12 GA. MIN. THICK = 0.105")
B) ALUMINUM : 6063-T5 MIN. (ALUM. 0.078" MIN. THICK)

MIAMI-DADE COUNTY
APPR'D MULLION
SEE SEPARATE NOA

1900 SW 44TH AVE.
OCALA, FLORIDA 34474
WWW.CWS.CC

7900 ALUMINUM SLIDING DOOR - IMPACT


NO.	DESCRIPTION	BY	DATE

DATE **DEC 18 2023**

THOMAS J. SOTOS, P.E.
FL. P.E. LIC. # 55225


SHEET DESCRIPTION:
2 TRACK VERTICAL CROSS SECTIONS, DETAILS & ANCHOR NOTES

DRAWN BY: N. Erazo	DATE: 12/18/2023
REV. BY: ---	DATE: ---
DWG #: CWS-1223	REV #:
SCALE: ---	SHEET 6 OF 14

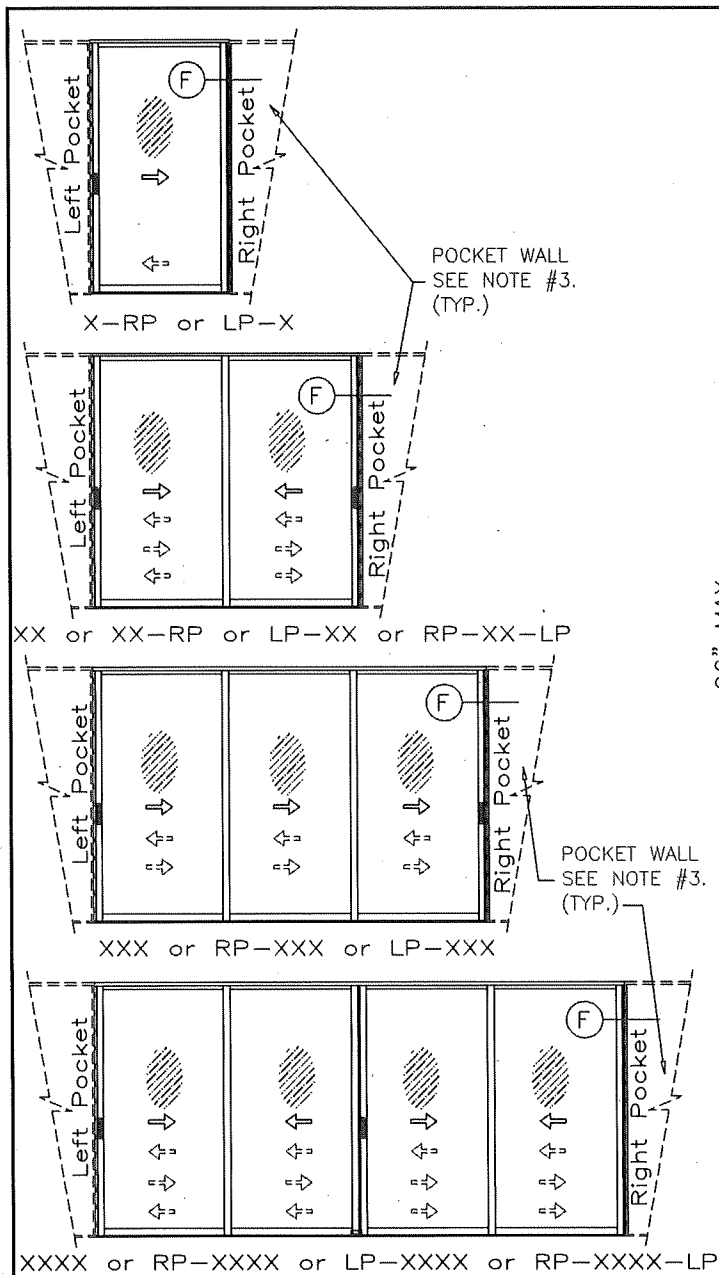


APPROVED CONFIGURATIONS WITH & WITHOUT POCKETS

(FOR PANEL STACK CONFIGURATIONS SEE SHEET 1.)

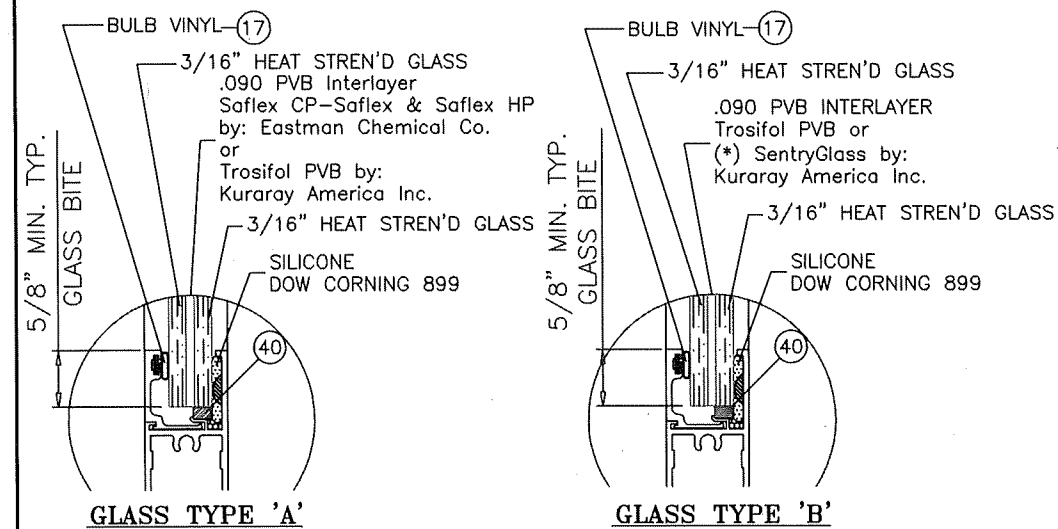

GLAZING DETAILS

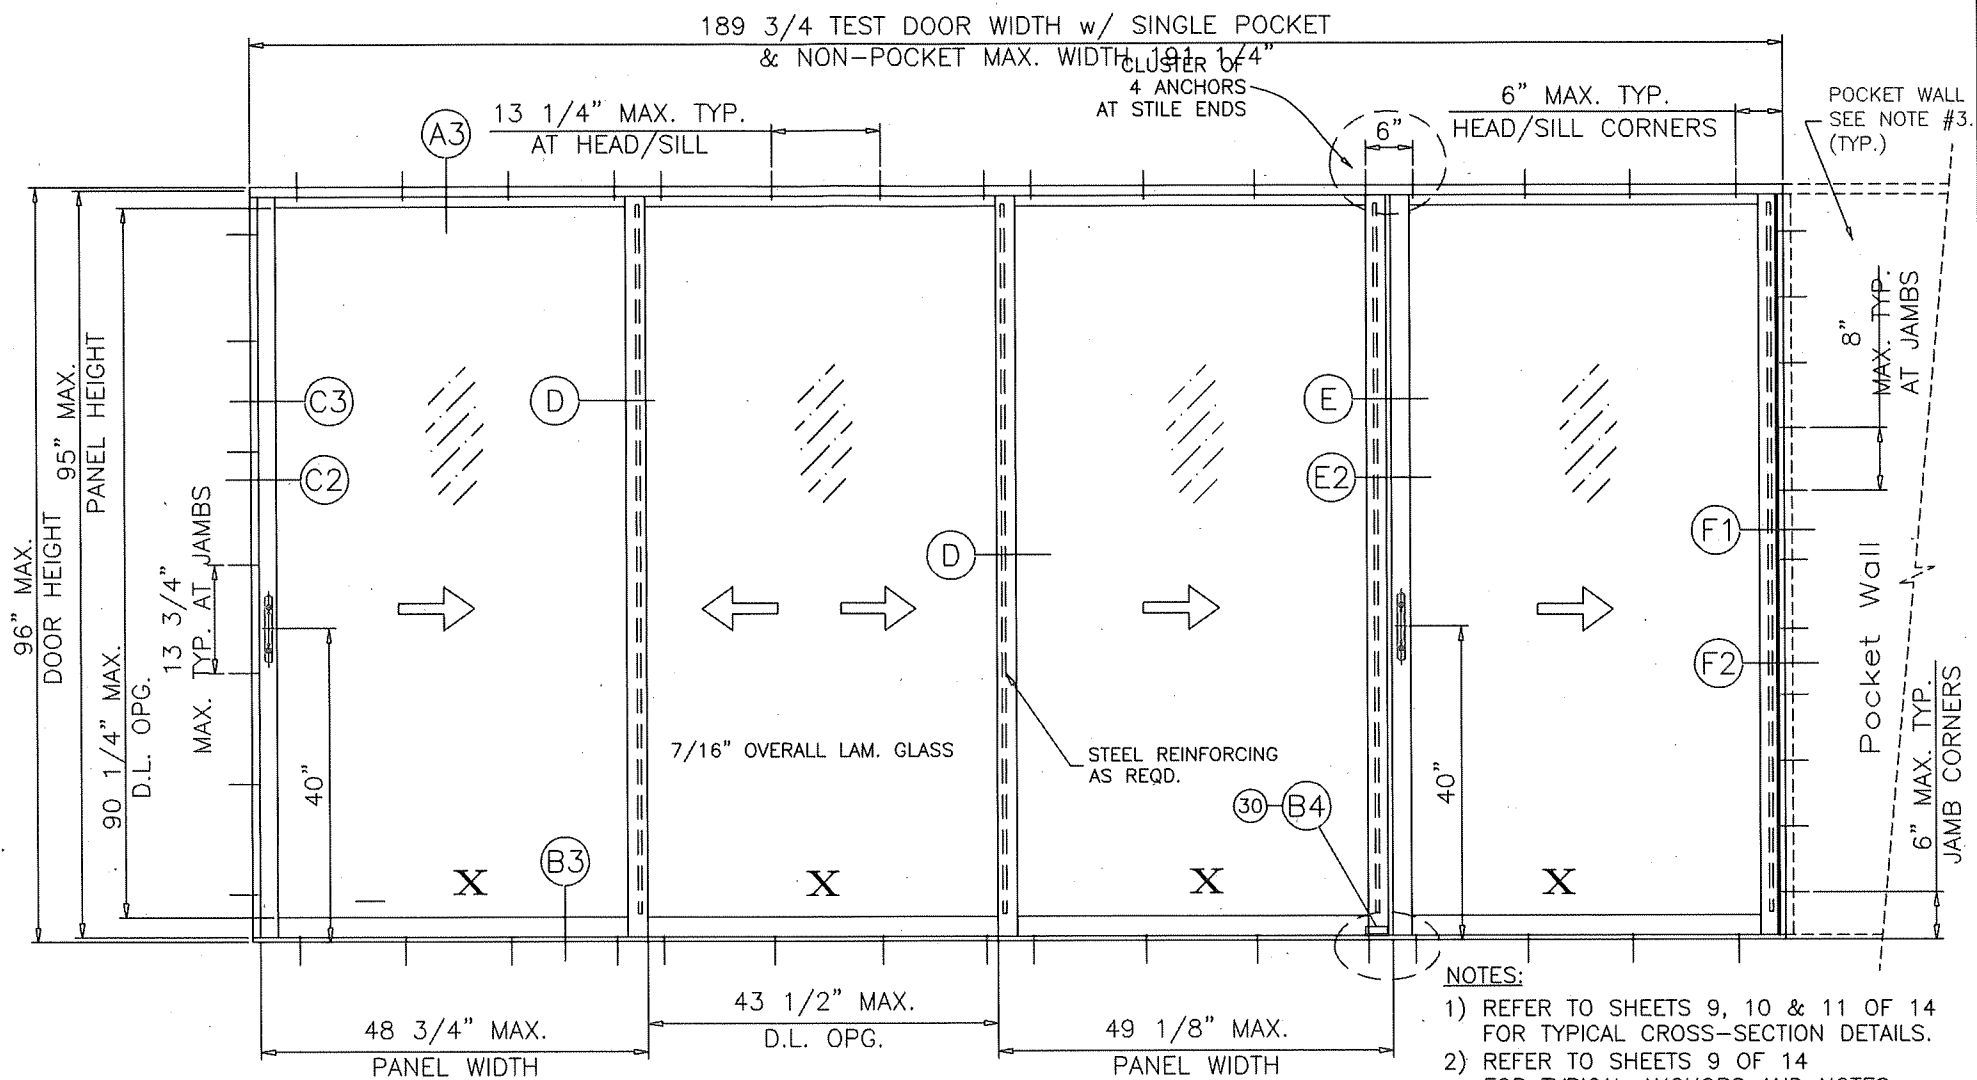

PANEL MAX. D.L.O.:
 3/0 X 6/8 = 31-1/2\" X 74-1/4\"
 4/0 X 6/8 = 43-1/2\" X 74-1/4\"
 3/0 X 8/0 = 31-1/2\" X 90-1/4\"
 4/0 X 8/0 = 43-1/2\" X 90-1/4\"

4 DOOR - THREE TRACK "XXXX" TYPICAL ELEVATION TESTED UNIT

- NOTES:
- 1) REFER TO SHEETS 9, 10 & 11 OF 14 FOR TYPICAL CROSS-SECTION DETAILS.
 - 2) REFER TO SHEETS 9 OF 14 FOR TYPICAL ANCHORS AND NOTES.
 - 3) FOR POCKET WALLS SEE GENERAL NOTES #15 & 16 AT SHEET 1 OF 14.

DOORS GLAZED WITH LAMINATED GLASS RATED FOR LARGE MISSILE IMPACT AND REQUIRE NO SHUTTERS.

NOMINAL DOOR SIZES WIDTH FT./IN.		DP CAPACITY - PSF (2 1/4\" SILL)				DP CAPACITY - PSF (3\" SILL)			
		GLASS TYPE 'A'		GLASS TYPE 'B'		GLASS TYPE 'A'		GLASS TYPE 'B'	
	HEIGHT FT./IN.	EXT. (+)	INT. (-)	EXT. (+)	INT. (-)	EXT. (+)	INT. (-)	EXT. (+)	INT. (-)
8/0 (2DR) (W/ 1 STEEL)	8/0	56.7	68.0	56.7	68.0	68.0	68.0	68.0	68.0
8/0 (2DR) (W/ 2 STEEL)	8/0	56.7	68.0	56.7	68.0	68.0	68.0	(*) 68.0	(*) 68.0
12/0 (3DR) (W/ 1 STEEL)	8/0	56.7	68.0	56.7	68.0	-	-	68.0	68.0
12/0 (3DR) (W/ 2 STEEL)	8/0	56.7	68.0	56.7	68.0	68.0	68.0	(*) 68.0	(*) 68.0
16/0 (4DR) (W/ 1 STEEL)	8/0	53.3	60.0	53.3	60.0	60.0	60.0	60.0	60.0
16/0 (4DR) (W/ 2 STEEL)	8/0	53.3	68.0	53.3	68.0	68.0	68.0	68.0	68.0

(*) 2dr/3dr DOORS MEET +76.7 & -78.0 DP w/ "Kuraray 0.090" SG Laminate

LAMINATED GLASS LARGE MISSILE IMPACT

PRODUCT REVISED
 as complying with the Florida
 Building Code
 NOA-No. 24-0116.13
 Expiration Date 02/13/2028
 By Isaac I. Chan
 Miami-Dade Product Control

7900 ALUMINUM SLIDING DOOR - IMPACT


NO.	DESCRIPTION:	BY:	DATE:

THOMAS J. SOTOS
 LICENSE
 No. 55225
 STATE OF
 FLORIDA
 PROFESSIONAL ENGINEER
 DEC 18 2023

DATE:	THOMAS J. SOTOS, P.E. FL. P.E. LIC. # 55225
SHEET DESCRIPTION:	APPROVED ELEVATIONS, GENERAL NOTES, GLAZING DETAILS & DP LOAD CHARTS
DRAWN BY:	DATE:
N. Erazo	12/18/2023
REV. BY:	DATE:
---	---
DWG #:	REV #:
CWS-1223	
SCALE:	SHEET
---	8 OF 14

**7900 ALUMINUM
SLIDING DOOR
- IMPACT**


NO.	DESCRIPTION	BY	DATE

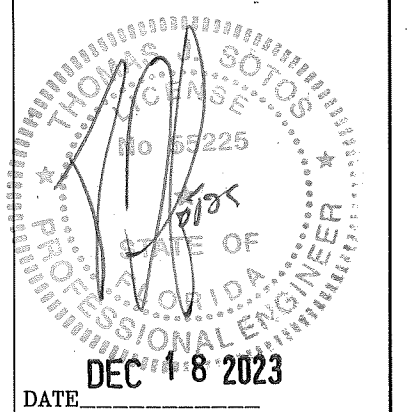



THOMAS J. SOTOS, P.E.
FL. P.E. LIC. # 55225

SHEET DESCRIPTION:
TWO DOOR & THREE DOOR
HORIZONTAL CROSS SECTIONS,
& NOTES

DRAWN BY: N. Erazo	DATE: 12/18/2023
REV. BY: ---	DATE: ---
DWG #: CWS-1223	REV #:
SCALE: ---	SHEET 10 OF 14

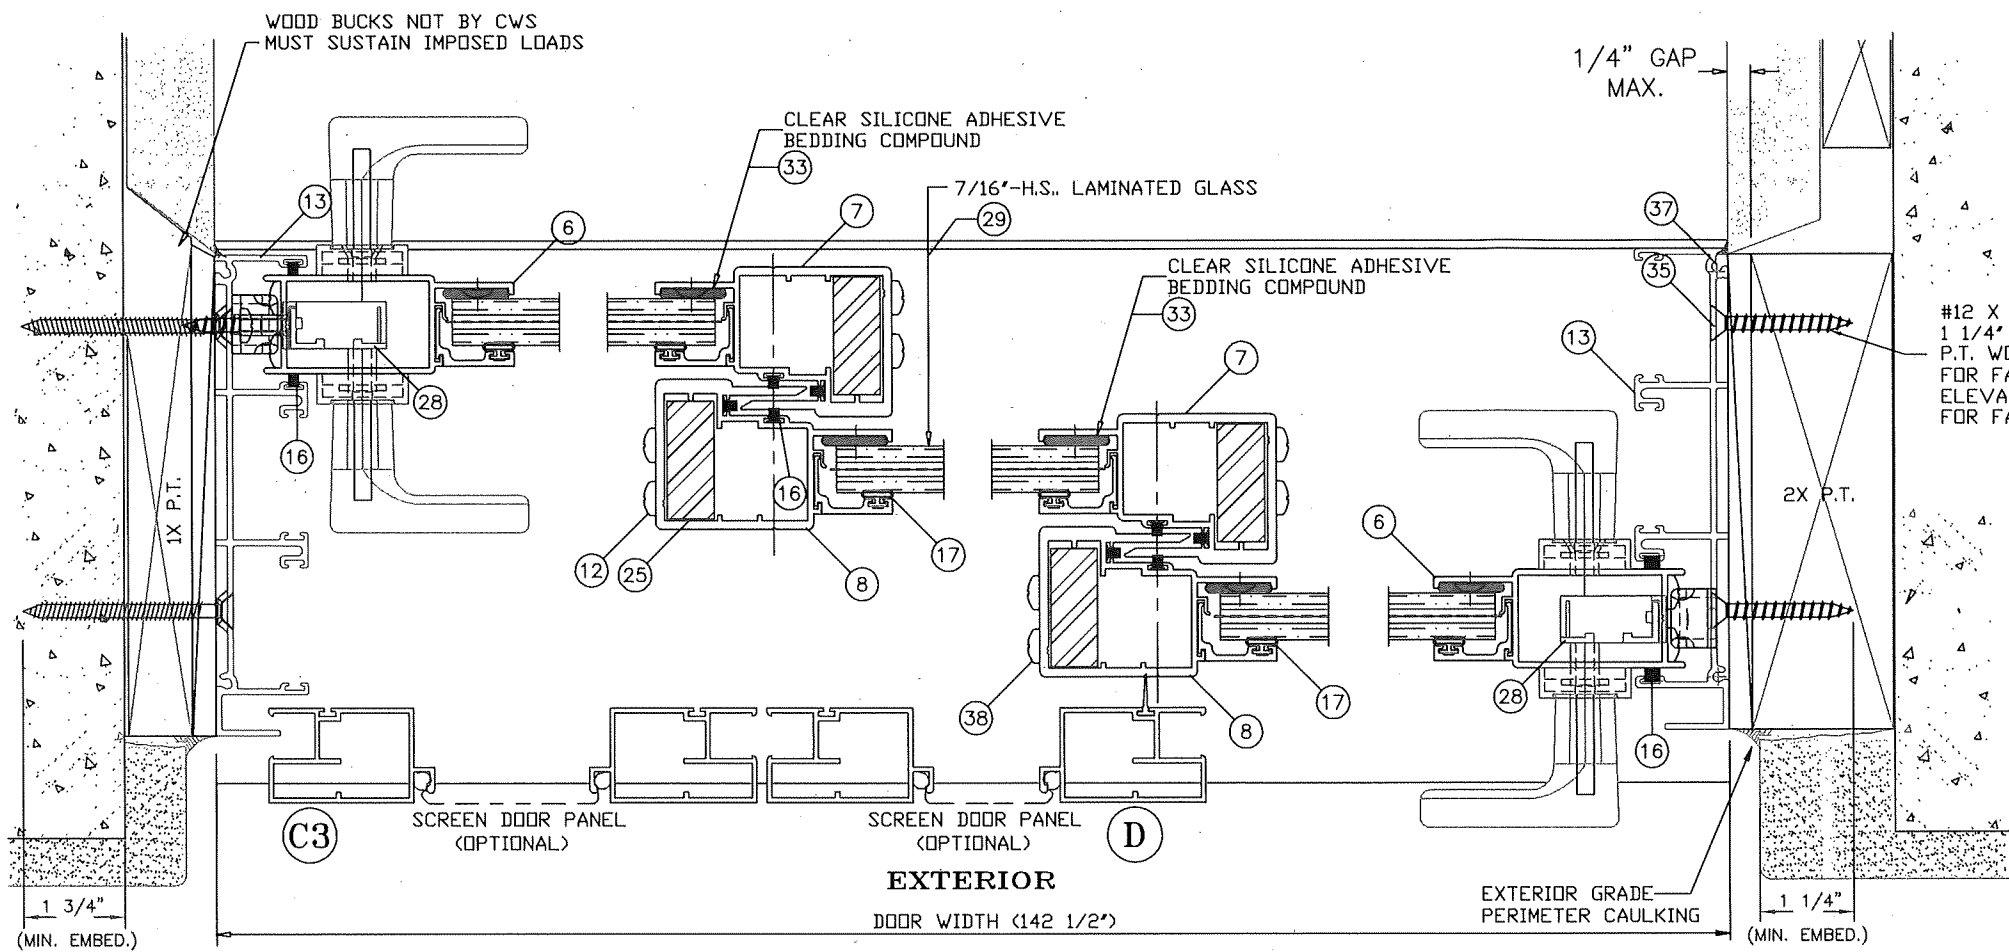


- NOTES: 1) REFER TO SHEET 8 OF 14
FOR GLAZING OPTIONS AND DP CHARTS.
2) REFER TO SHEET 9 OF 14
FOR VERTICAL CROSS-SECTION DETAILS.
3) REFER TO SHEET 9 OF 14
FOR TYPICAL ANCHORS AND NOTES.
4) REFER TO SHEET 8 OF 14
FOR MAX. ANCHOR SPACINGS.

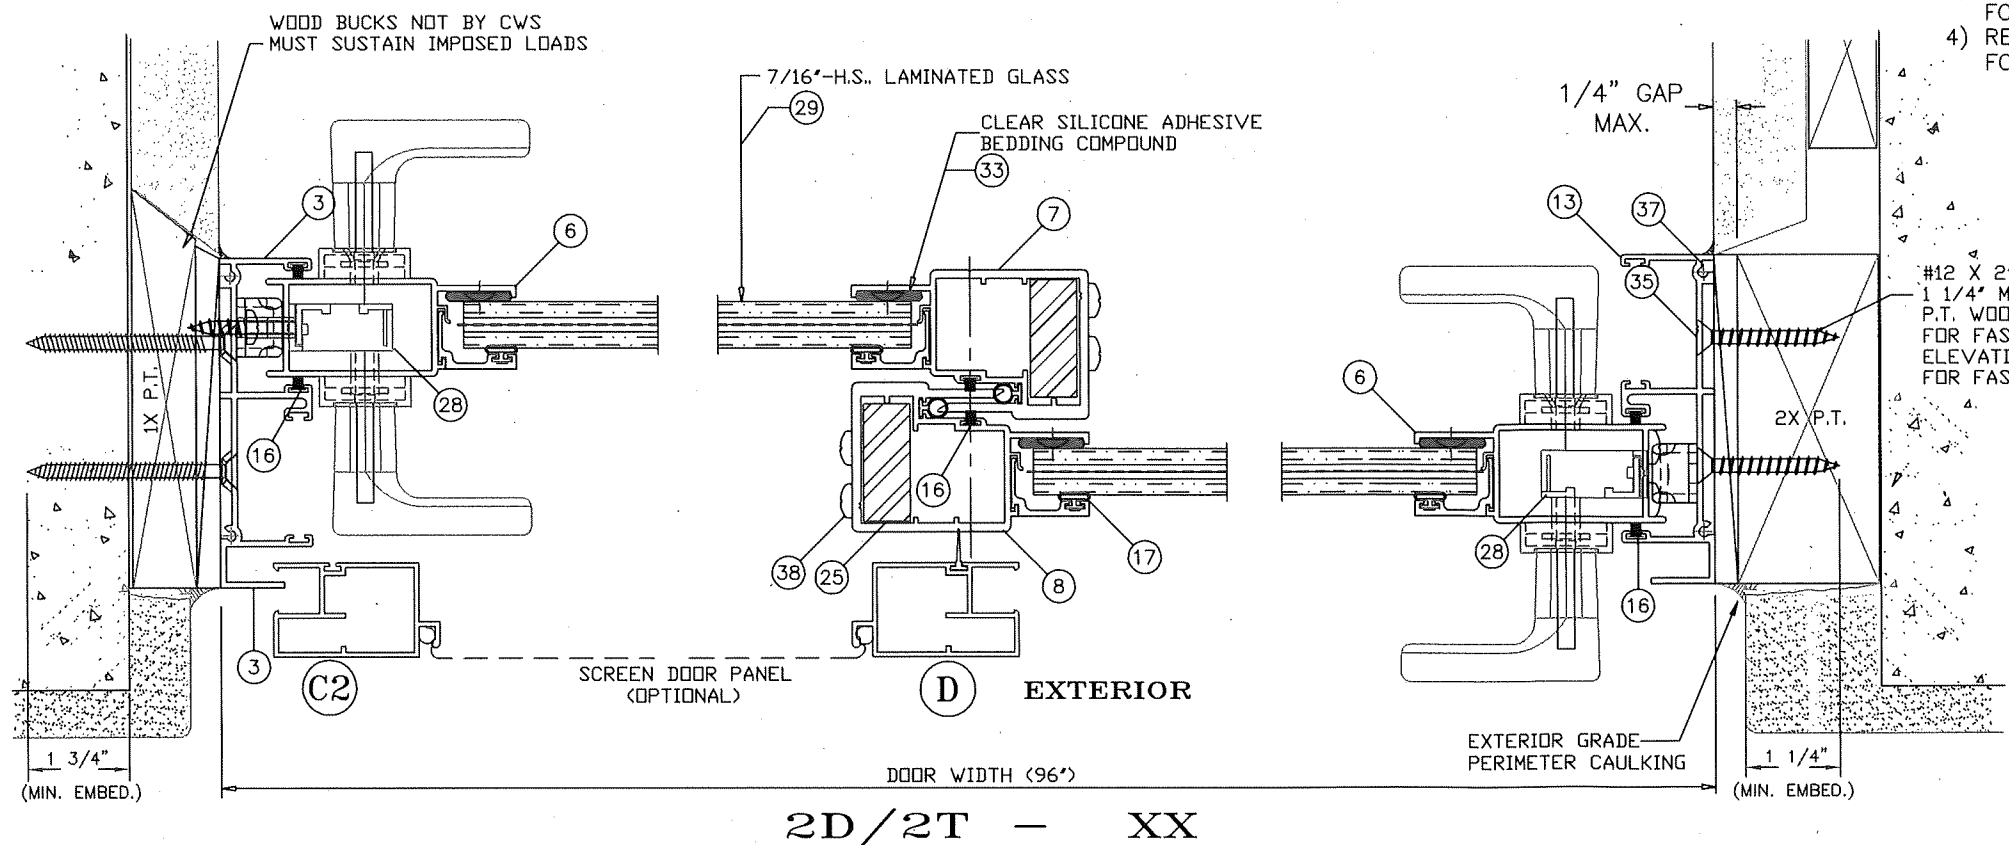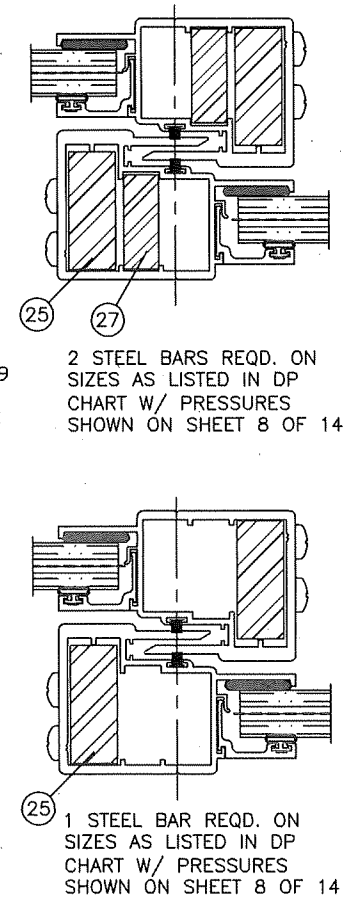

PRODUCT REVISED
as complying with the Florida
Building Code
NOA-No. 24-0116.13
Expiration Date 02/13/2028
By *Isang I. Chanda*
Miami-Dade Product Control

1900 SW 44TH AVE.
OCALA, FLORIDA 34474
WWW.CWS.CC

**7900 ALUMINUM
SLIDING DOOR
- IMPACT**

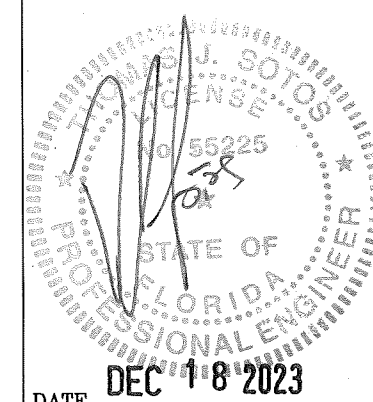[illegible]

THOMAS J. SOTOS, P.E.
FL. P.E. LIC. # 55225


SHEET DESCRIPTION:
FOUR DOOR HORIZONTAL
CROSS SECTIONS, INSTALLATION
DETAILS & NOTES

DRAWN BY:	DATE:
N. Erazo	12/18/2023

REV. BY:	DATE:
---	---


DWG #:	REV #:
CWS-1223	

SCALE: ---	SHEET 11 OF 14
---------------	-------------------

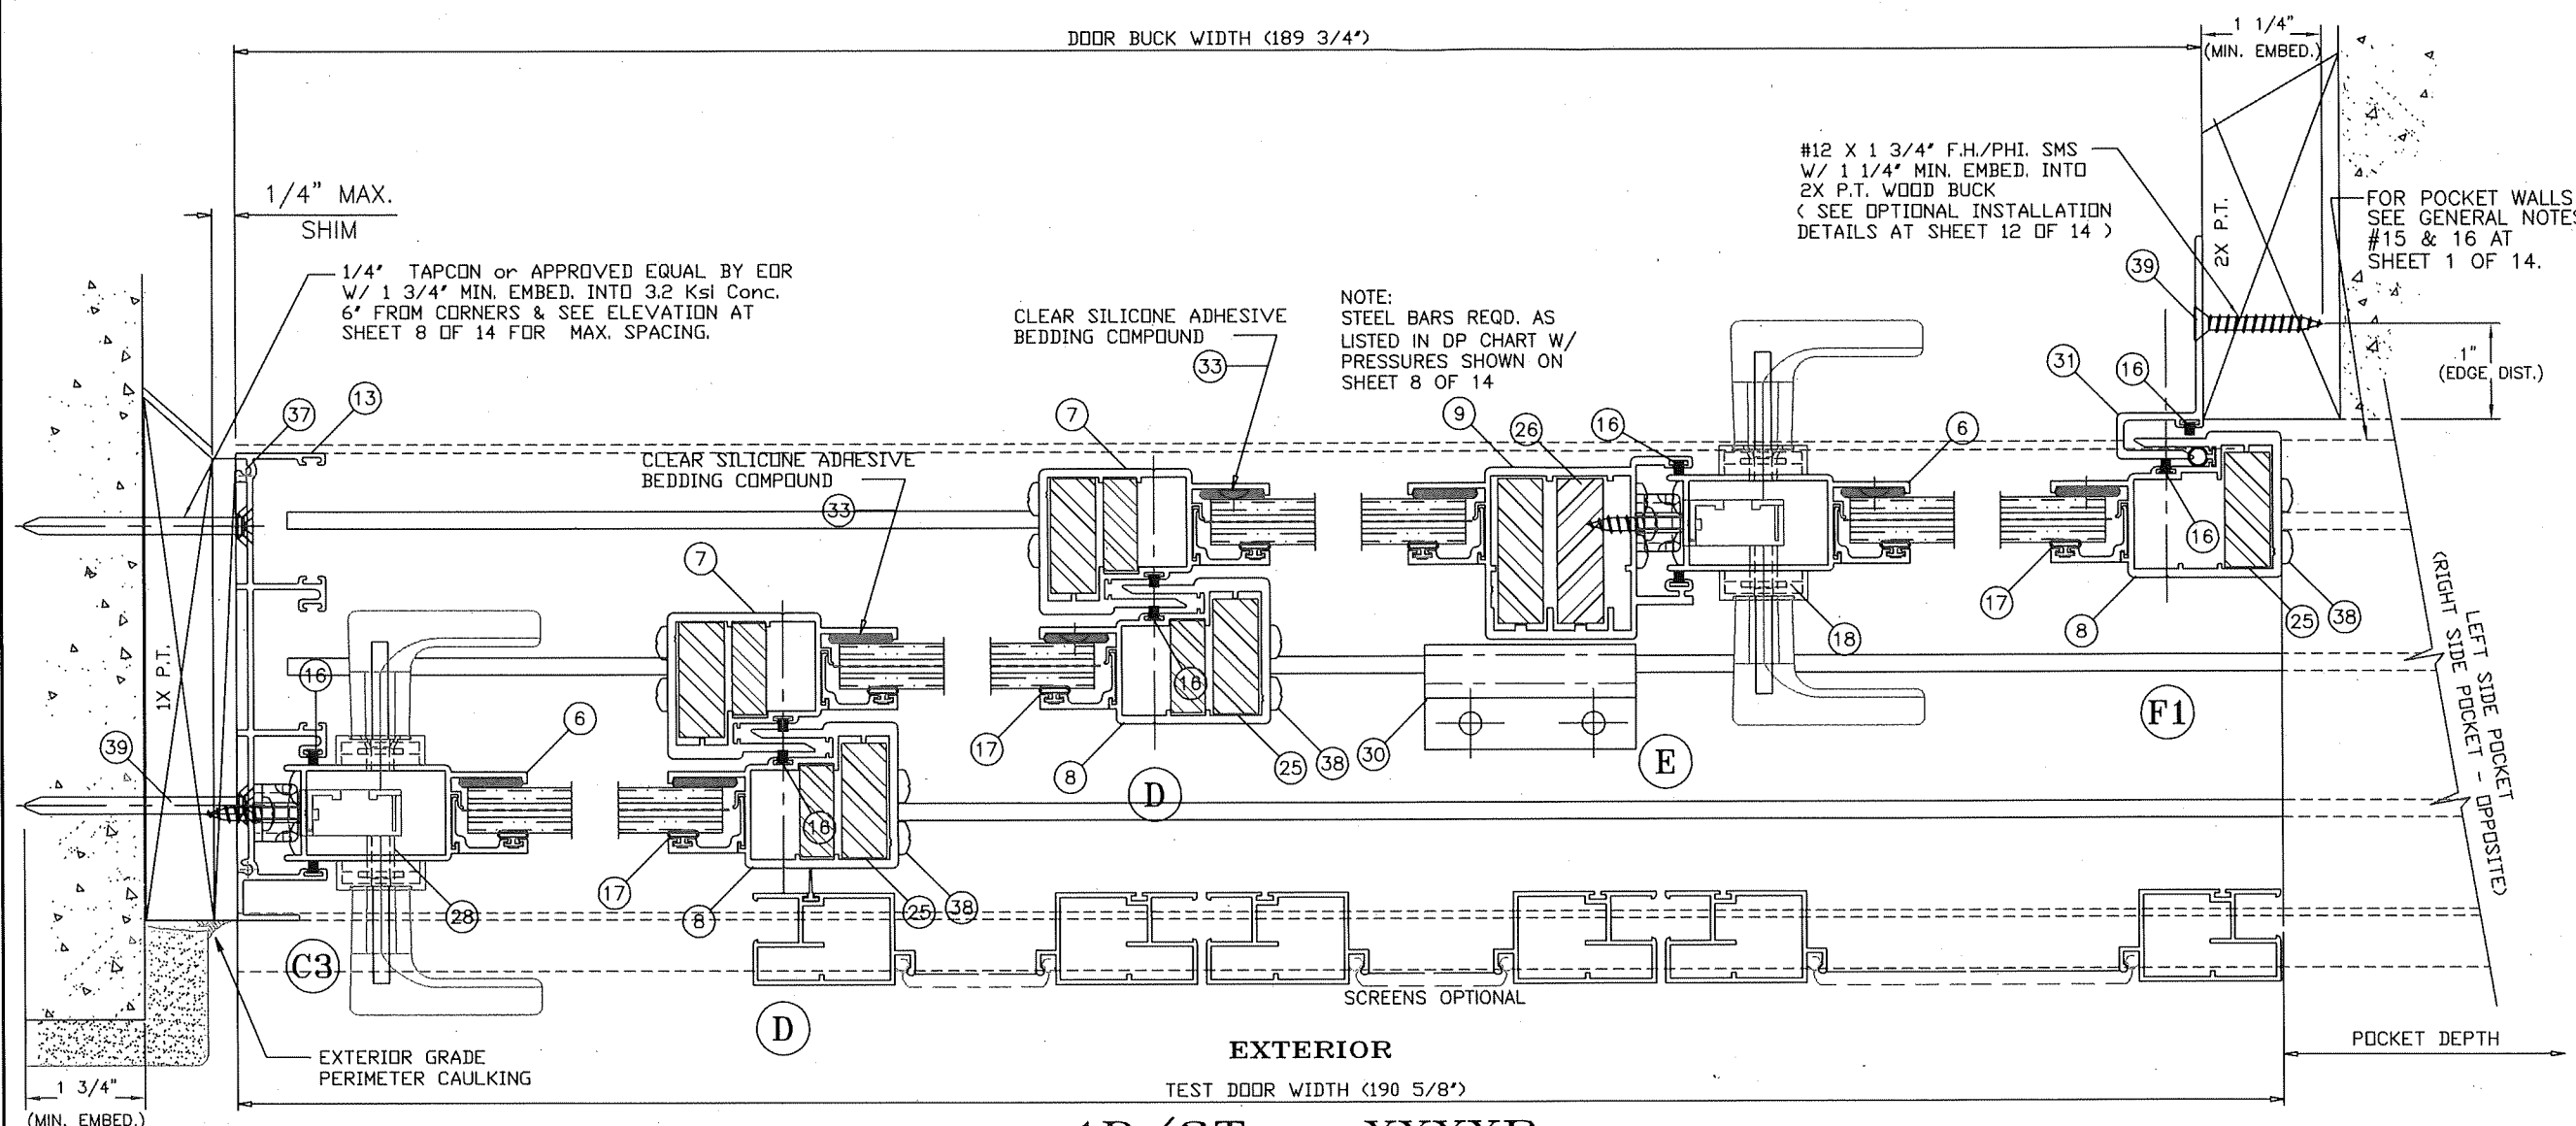

4D/3T - XXXXP


- NOTES: 1) REFER TO SHEET 8 OF 14
FOR GLAZING OPTIONS AND DP CHARTS.
2) REFER TO SHEET 9 OF 14
FOR VERTICAL CROSS-SECTION DETAILS.
3) REFER TO SHEET 9 OF 14
FOR TYPICAL ANCHORS AND NOTES.
4) REFER TO SHEET 8 OF 14
FOR MAX. ANCHOR SPACINGS.

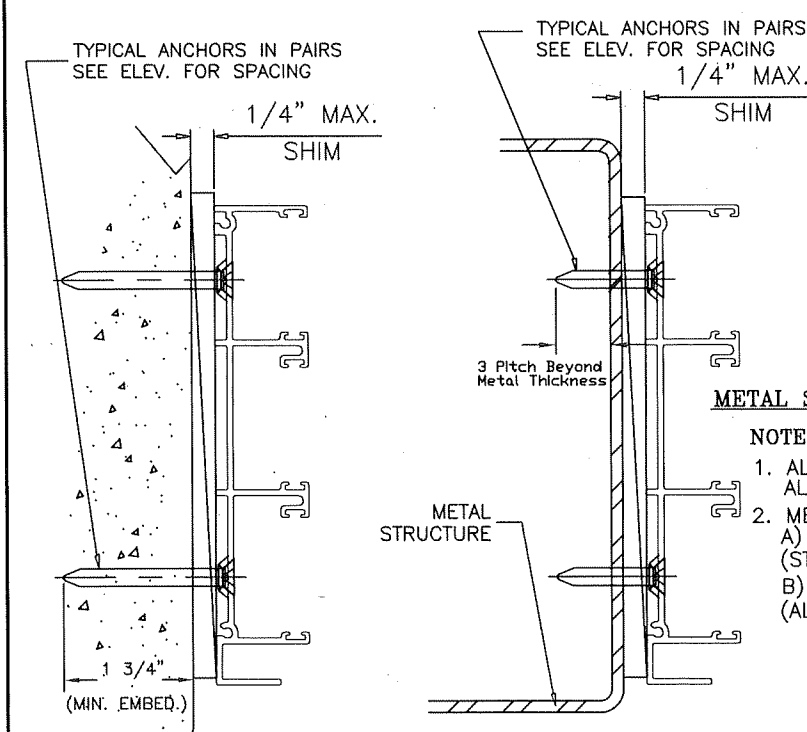

METAL STRUCTURE ATTACHMENT DETAIL

NOTE:

1. ALL STEEL IN CONTACT WITH ALUM. TO BE PAINTED OR PLATED.
2. METAL STRUCTURES:
 - A) STEEL : $F_y = 36$ KSI MIN.
(STEEL 12 GA. MIN. THICK - 0.105")
 - B) ALUMINUM : 6063-T5 MIN.
(ALUM. 0.078" MIN. THICK)

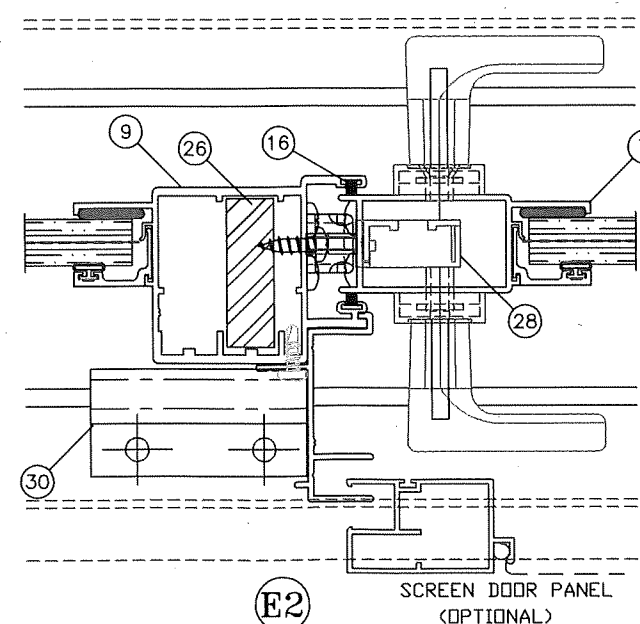


PRODUCT REVISED
as complying with the Florida
Building Code

NOA-No. 24-0116.13

Expiration Date 02/13/2028

By Ishaq I. Chande
Miami-Dade Product Control

BILL OF MATERIALS - 2 & 3 TRACK FRAME				
ITEM #	PART #	QTY.	DESCRIPTION	REMARKS
1	L-9211	1	2 TRACK FRAME HEAD	6063-T6 ALUMINUM
1.2	L-9211	1	2 TRACK FRAME HEAD (Multi-Slide)	6063-T6 ALUMINUM
2	L-9206	1	2 TRACK FRAME SILL	6063-T5 ALUMINUM
3	L-9212	2	2 TRACK FRAME JAMB	6063-T5 ALUMINUM
4	L-9204	1 X PANEL	PANEL TOP RAIL	6063-T5 ALUMINUM
5	L-9205	1 X PANEL	PANEL BOTTOM RAIL	6063-T5 ALUMINUM
6	L-9201	1	PANEL LOCK STILE	6063-T6 ALUMINUM
7	L-9202	1	PANEL INTERIOR INTERLOCK	6063-T6 ALUMINUM
8	L-9203	1	PANEL EXTERIOR INTERLOCK	6063-T6 ALUMINUM
9	L-9207	1	PANEL ASTRAGAL	6063-T6 ALUMINUM
10	L-9209	AS REQ'D.	ALUMINUM GLAZING BEAD	6063-T5 ALUMINUM
11	L-9214	1	3 TRACK FRAME HEAD	6063-T6 ALUMINUM
12	L-9208	1	3 TRACK FRAME SILL	6063-T5 ALUMINUM
13	L-9213	2	3 TRACK FRAME JAMB	6063-T5 ALUMINUM
14	PWS-016	AS REQ'D.	BOTTOM RAIL WTS'P	ULTRAFAB #QB6757DK
15	PWS-009	AS REQ'D.	PANEL TOP RAIL WTS'P	.187"x.310" (7830-6001-1)
16	PWS-003	AS REQ'D.	FIN SEAL WEATHERSTRIP	.187"x.210" (7820-6001-9)
17	VWS-004	AS REQ'D.	BULB VINYL (FPVC)	1/4" O.D.
18	L-9016	2	SELF ADHESIVE PILE PAD	13/16" X 1 1/2"
19	HC-046	2	MVG. PANEL TANDEM ROLLER	2 X EA. MVG. BOT. RAIL
20	FS-003	2	ROLLER ATTACHMENT SCREW	#8 X 1/2" F.H./PHIL.
21	AR-008	2X PANEL	PANEL 'C' TRACK CLIP	6063-T6 ALUMINUM
22	FS-042	AS REQ'D.	'C' TRACK ATTACHMENT SCREW	#10 X 1" SMS F.H./PHIL.
23	L-9018	1 X ANCHOR	FIXED PANEL JAMB CLIP	6063-T5 ALUMINUM
24	FS-011	1 X CLIP	FIXED PANEL CLIP SCREW	#10 X 5/8" PH/PHIL.
25	AR-020	*	INTERLOCK STEEL REINFORCEMENT	1/2" X 1 1/4" (36 KSI)
26	AR-021	*	ASTRAGAL STEEL REINFORCEMENT	1/2" X 1 1/2" (36 KSI)
27	AR-024	*	INTERLOCK STEEL REINFORCEMENT	3/8" X 1" (36 KSI)
28	HC-047	1	MORTISE LOCK HARDWARE	W/ HANDLES & KEEPER
29	*	1 x Panel	7/16" Laminated H.S. Glass	See Glazing Details
30	L-9022	*	ASTRAGAL PANEL SILL CLIP	6063-T5 ALUMINUM
31	L-9215	1	POCKET JAMB HOOK	6063-T6 ALUMINUM
32	SM-5731	*	NEUTRAL CURE SILICONE	Schnee-Morehead 5731
33	DC-899	AS REQ'D.	NEUTRAL CURE SILICONE	Dow Corning 899
34	*	*	NEUTRAL CURE SILICONE	Tremco Spectrem 2
35	HC-045	2	NYLON PLUG (.480" HOLE)	RIGID PVC
36	HC-043	2X PANEL	NYLON TOP GUIDE	RIGID PVC
37	FS-005	AS REQ'D.	FRAME ASSEMBLY SCREWS	#8 X 1/2" P.H. PHILLIPS
38	FS-013	AS REQ'D.	PANEL ASSEMBLY SCREWS	#10 X 1" P.H. PHILLIPS
39	FS-014	AS REQ'D.	INSTALLATION SCREWS	#12 X 1 3/4" F.H./PHIL.
40	PL 75.6020	AS REQ'D.	GLAZING SETTING BLOCK	SOFT PVC 1/8" x 1/8" x 2"L.
41	*	-	SCREEN PANEL	*
42	SM-5504	AS REQ'D.	JOINT SEALANT	Schnee-Morehead 5504
43	*	*	PERIMETER CAULKING	DSI POLYSEAMSEAL
44	*	1	PRODUCT LABEL	*

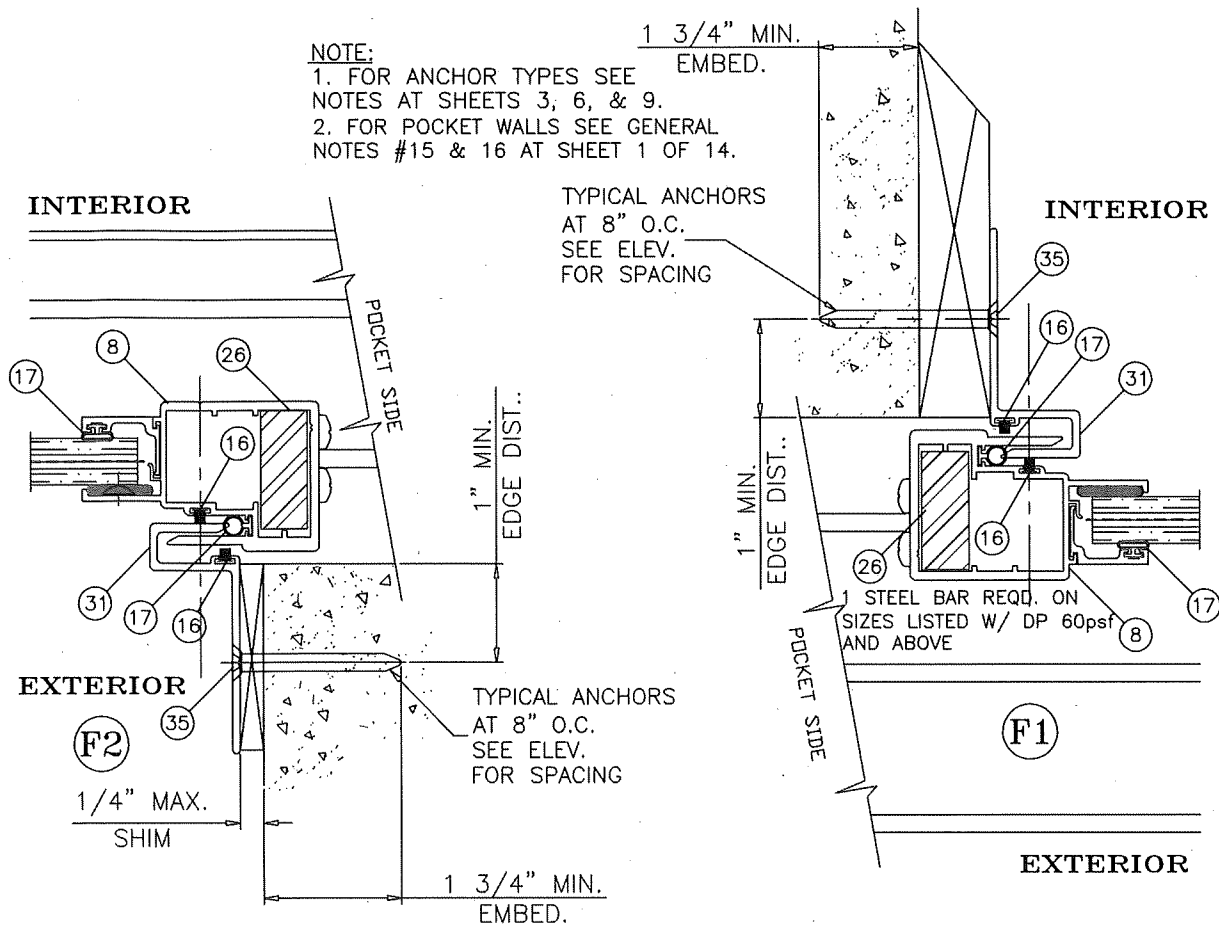

POCKET DOOR HOOK ATTACHMENT DETAILS

Flexible Vinyl (FPVC) Composition - Team Plastics, Inc.			
*1. FPVC Black: Compound No. 7200-75			
PHYSICAL			ASTM NO.
Durometer Hardness "A", 10 sec	75		D-2240
Specific Gravity	1.45		D-792
Tensile Strength, PSI	1640		D-638
Ultimate Elongation, %	340.0		D-638
Modulus @ 100% Elongation, PSI	765.0		D-638
Impact Brittleness,	-31.0		D-746
*2. FPVC White: Compound No. 7267-75			
PHYSICAL			ASTM NO.
Durometer Hardness "A", 10 sec	75		D-2240
Specific Gravity	1.45		D-792
Tensile Strength, PSI	1640		D-638
Ultimate Elongation, %	325.0		D-638
Modulus @ 100% Elongation, PSI	765.0		D-638
Impact Brittleness,	-30.0		D-746

PRODUCT REVISED
as complying with the Florida Building Code
NOA-No. 24-0116.13
Expiration Date 02/13/2028
By Ishag I. Chande
Miami-Dade Product Control

1900 SW 44TH AVE.
OCALA, FLORIDA 34474
WWW.CWS.CC

7900 ALUMINUM SLIDING DOOR - IMPACT				
NO.	DESCRIPTION	BY	DATE	REVISIONS






DATE DEC 18 2023

THOMAS J. SOTOS, P.E.
FL. P.E. LIC. # 55225

SHEET DESCRIPTION:
BILL OF MATERIALS,
POCKET JAMB HOOK
ATTACHMENT DETAILS

DRAWN BY: N. Erazo	DATE: 12/18/2023
REV. BY: ---	DATE: ---
DWG #: CWS-1223	REV #:
SCALE: ---	SHEET 12 OF 14



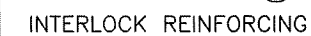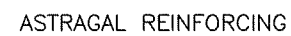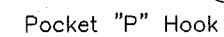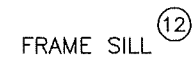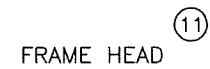

SCALE: ---	SHEET 14 OF 14
---------------	-------------------